

LEE MISSISSIPPI BOARD OF WATER COMMISSIONERS

K 40

3-30-62

WATER WELL DRILLERS LOG



Date: April 30 1962, Driller: HERNDON WELL & SUPPLY CO.
P. O. BOX 42 County Lee
SHANNON, MISSISSIPPI

(1) Owner of Land:	Description & Color of Materials Sand, Clay, Red Clay, Shell, etc.	Thick- ness Feet	Depth Feet
<u>Mrs. W. H. Stovall</u> (Name) <u>423 Tupelo Miss.</u> (Address)	<u>Surface sand</u>		<u>0</u>
(2) Location: <u>1/4, 22 10 1/2</u> , Sec. <u>10 1/2</u> , T. <u>5 N</u> , R. <u>5 E</u> <u>3</u> miles <u>W</u> , of <u>Verona</u> (distance) (direction) (Nearest Town)	<u>Blue rock</u>	<u>20</u>	
(3) Topography: <u>Hilly</u> (Hilly) (Flat) (Level)	<u>sand</u>	<u>8</u>	<u>360</u>
(4) Purpose of Well: <u>Domestic</u> (Domestic Irrigation Municipal, Industrial, Other)	<u>white frame</u>		<u>480</u>

Information upon completion of well:

- (1) Diameter 4 inches.
- (2) Total Depth 480 feet.
- (3) Water Level 150 feet below top of ground.
- (4) Cased to 22' 3", Size 4"
- (5) Screen: Size —, Length —
- (6) Were any formations sealed against pollution?
yes, no.

If YES, depth of formation 20'
Why Surface & sand
Drillers Remarks: rod
may be able to get W.L.

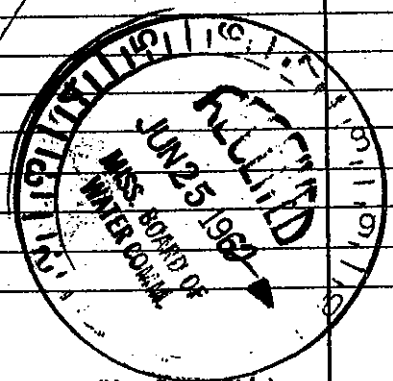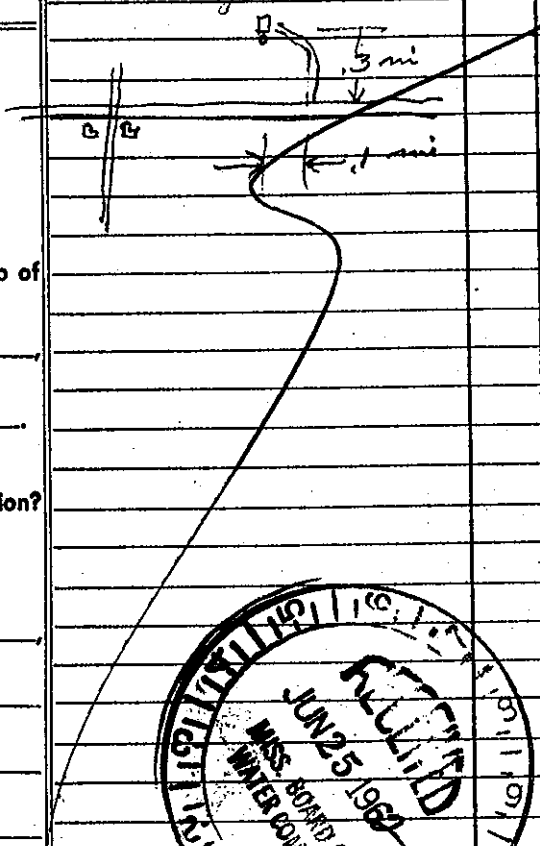

(Use Back Side)

Well No.

189 ELEV 320

Mail this copy to Board of Water Commissioners 429 Miss. St. Jackson, Miss.