

LEE

K 41

4-26-62

MISSISSIPPI BOARD

WATER WELL DRILLERS LOG

Date: 4/26, 1962, Driller: Fowler, County Lee

D.S. Colburn (Name)

(1) Owner of Land:	Description & Color of Materials Sand, Clay, Red Clay, Shell, etc.	Thick- ness Feet	Depth Feet
D.S. Colburn (Name) Verona (Address)	white house with brown trim		
(2) Location: 1/4, 1/4, Sec. 25 10 SE 1/2 miles S, of Verona (distance) (direction) (Nearest Town)	across from school house		
(3) Topography: hilly (Hilly) (Flat) (Level)	on HW 45 near hill top		
(4) Purpose of Well: Domestic (Domestic Irrigation Municipal, Industrial, Other)			



Information upon completion of well:

- (1) Diameter 4" inches.
- (2) Total Depth 427' feet.
- (3) Water Level 90' feet below top of ground.
- (4) Cased to 22', Size 4"
- (5) Screen: Size _____, Length _____
- (6) Were any formations sealed against pollution?
_____ yes, _____ no.

If YES depth of formation _____

Why _____

Drillers Remarks: _____

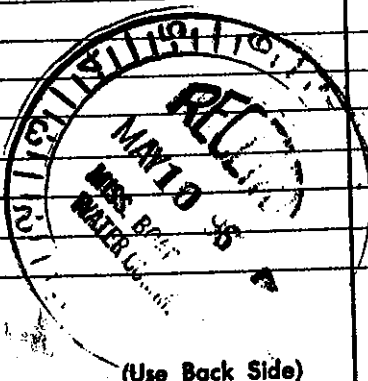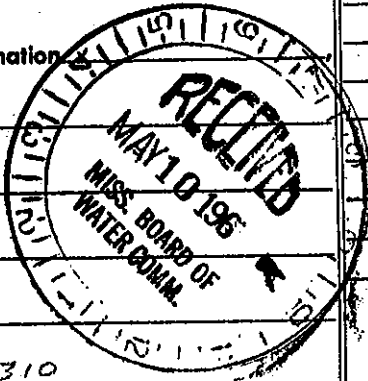

(Use Back Side)

Well No.

190 ELEU 310

Mail this copy to Board of Water Commissioners 429 Miss. St. Jackson, Miss