

LEE  
K 92  
8-31-62

MISSISSIPPI BOARD OF WATER COMMISSIONERS


WATER WELL DRILLERS LOG

Date Aug 31, 1962, Driller: HERNDON WELL & SUPPLY CO County Lee  
BURNET SHANNON, MISSISSIPPI

(1) Owner of Land:	Description & Color of Materials Sand, Clay, Red Clay, Shell, etc.	Thick- ness Feet	Depth Feet
<u>(DECEASED) Herbert Long</u> (Name) <u>203 Tupelo, Miss.</u> (Address)	<u>surface sand</u> <u>&amp; clay</u>		<u>0</u>
(2) Location: <u>1/4, 1/4, Sec. 17 T. 105 R. 5E</u> <u>5</u> miles <u>W</u> , of <u>Verona</u> (distance) (direction) (Nearest Town)	<u>Blue rock</u> <u>5</u> <u>sand</u> <u>8</u>		<u>18</u> <u>480</u>
(3) Topography: <u>Flat Hill Top</u> (Hilly) (Flat) (Level)	<u>Bottom</u>		<u>600</u>
(4) Purpose of Well: <u>Domestic</u> (Domestic Irrigation Municipal, Industrial, Other)			


Information upon completion of well:

- (1) Diameter 5" inches.
- (2) Total Depth 600 feet.
- (3) Water Level 150 feet below top of ground.
- (4) Cased to 20' 8", Size 5"
- (5) Screen: Size —, Length —
- (6) Were any formations sealed against pollution?  
 yes,  no.

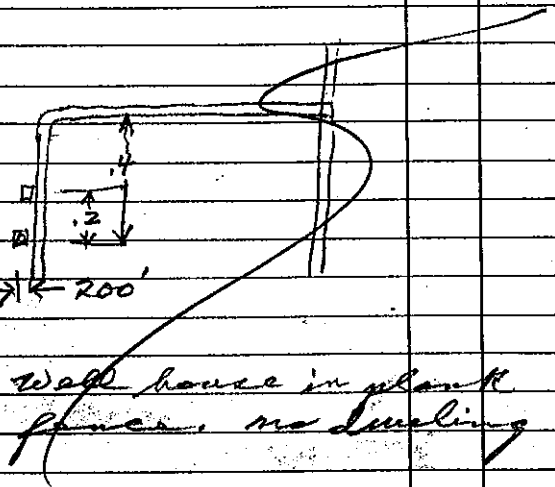

If YES depth of formation 18  
 Why surface & sand  
 Drillers Remarks:

192 ELEV 345

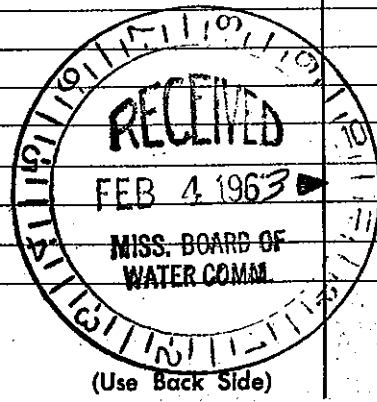

Well No.