

LEE

MISSISSIPPI BOARD OF WATER COMMISSIONERS

K 43

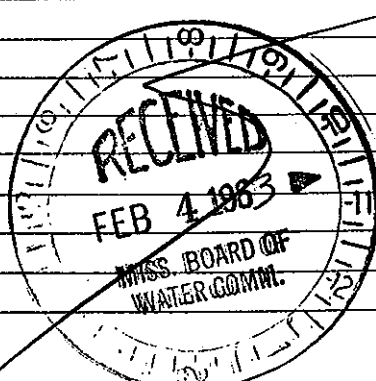
WATER WELL DRILLERS LOG

9-5-62

HERNDON WELL & SUPPLY CO.

Date Sept 5, 1962, Driller: P. O. BOX 42 County Lee

SHANNON, MISSISSIPPI

(1) Owner of Land: <u>Fred Anderson</u> (Name)	Description & Color of Materials Sand, Clay, Red Clay, Shell, etc.	Thick- ness Feet	Depth Feet
<u>At 4 Tupelo, Miss.</u> (Address)	<u>clay</u>		<u>0</u>
(2) Location: <u>10 103</u> <u>R 3E</u> 1/4, 1/4, Sec <u>10</u> T <u>103</u> R <u>3E</u>	<u>lime rock</u>		<u>5</u>
<u>2</u> miles <u>SW</u> of <u>Tupelo</u> (distance) (direction) (Nearest Town)	<u>Blue rock</u>		<u>11</u>
(3) Topography: <u>Flat</u> (Hilly) (Flat) (Level)	<u>Rock</u>		<u>82</u>
(4) Purpose of Well: <u>Domestic</u> (Domestic Irrigation Municipal, Industrial, Other)	<u>Blue rock</u>		<u>83</u>
Information upon completion of well:			
(1) Diameter <u>4</u> inches.	<u>rock</u>		<u>149</u>
(2) Total Depth <u>500</u> feet.	<u>5 shale</u>		<u>150</u>
(3) Water Level <u>1 1/2</u> feet below top of ground.	<u>Sand & shale</u>		<u>157</u>
(4) Cased to <u>300ft</u> , Size <u>4 in.</u>	<u>Blue rock</u>		<u>214</u>
(5) Screen: Size <u>—</u> , Length <u>—</u>	<u>Sand</u>		<u>350</u>
(6) Were any formations sealed against pollution? <input checked="" type="checkbox"/> yes, <input type="checkbox"/> no.	<u>Bottom</u>		<u>500</u>
If YES depth of formation <u>214 ft.</u>			
Why <u>Surface & sand</u>			
Drillers Remarks: <u>not located</u>			
<u>193 ELEV 340</u>			

Well No.

(Use Back Side)

Mail this copy to Board of Water Commissioners 429 Miss. St. Jackson, Miss.