


LEE  
K 44  
9-12-62

MISSISSIPPI BOARD OF WATER COMMISSIONERS

WATER WELL DRILLERS LOG  
HERNDON WELL & SUPPLY CO.

Date: Sept 12 1962, Driller: P. O. BOX 42  
SHANNON, MISSISSIPPI County Lee  
DENNIS CAYSON (Name)

(1) Owner of Land:	Description & Color of Materials Sand, Clay, Red Clay, Shell, etc.	Thick- ness Feet	Depth Feet
<u>Dennis Cayson</u> (Name) <u>At 4 Tupelo, Miss.</u> (Address)	<u>Surface sand</u> <u>&amp; clay</u>		<u>0</u>
(2) Location: <u>1/4, 1/4, Sec 14 T 10 S R 2 E</u> <u>2 miles W</u> of <u>Uxbridge</u> (distance) (direction) (Nearest Town)	<u>Blue rock</u> <u>5</u> <u>Sand</u>		<u>20</u> <u>50</u>
(3) Topography: <u>Flat</u> (Hilly) (Flat) (Level)	<u>Hard rock</u>		<u>160</u>
(4) Purpose of Well: <u>Domestic</u> (Domestic Irrigation Municipal, Industrial, Other)	<u>Blue rock</u> <u>5</u>		<u>161</u>
Information upon completion of well:			
(1) Diameter <u>4</u> inches.	<u>Hard rock</u>		<u>200</u>
(2) Total Depth <u>460</u> feet. <u>1280 3/2/67</u>	<u>Blue rock</u> <u>5</u>		<u>201</u> <u>201</u>
(3) Water Level <u>120</u> feet below top of ground.	<u>Sand</u> <u>5</u>		<u>270</u>
(4) Cased to <u>242' 8"</u> Size <u>4"</u>	<u>Bottom</u>		<u>460</u>
(5) Screen: Size <u>    </u> , Length <u>    </u> .			
(6) Were any formations sealed against pollution? <u>    </u> yes, <u>    </u> no.			
If YES depth of formation <u>    </u>			
Why <u>Surface &amp; sand</u>			
Drillers Remarks: <u>    </u>			
<u>194 ELEV 305</u>			

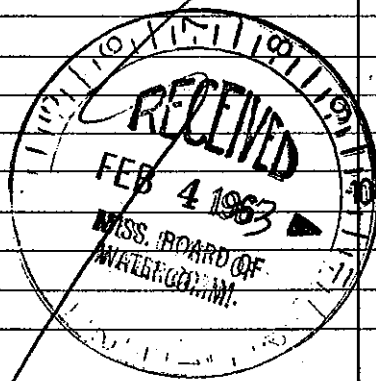

(Use Back Side)

Well No.

Mail this copy to Board of Water Commissioners 429 Miss. St. Jackson, Miss