

LEE
K 95

MISSISSIPPI BOARD OF WATER COMMISSIONERS


10-9-62

WATER WELL DRILLERS LOG

HERNDON WELL & SUPPLY CO.

Date: 10-9, 1962, Driller: P. O. BOX 42 County: Lee
SHANNON, MISSISSIPPI

	Description & Color of Materials Sand, Clay, Red Clay, Shell, etc.	Thick- ness Feet	Depth Feet
(1) Owner of Land: <u>Gay Ruff</u> (Name) <u>Rt 4 Tupelo, Miss.</u> (Address)	<u>clay</u>		<u>0</u>
(2) Location: <u>1/4, 1/4, Sec 11 T 105 R 2E</u> <u>2 miles SW</u> of <u>Tupelo</u> (distance) (direction) (Nearest Town)	<u>Blue shale</u>		<u>17</u>
(3) Topography: <u>Flat</u> (Hilly) (Flat) (Level)	<u>Shale</u>		<u>87</u>
(4) Purpose of Well: <u>Domestic</u> (Domestic Irrigation Municipal, Industrial, Other)	<u>Shale</u>		<u>140</u>
Information upon completion of well:	<u>Sand</u>		<u>153</u>
(1) Diameter: <u>4</u> inches.	<u>Combo</u>		<u>195</u>
(2) Total Depth: <u>545</u> feet.	<u>Blue m. s.</u>		<u>260</u>
(3) Water Level: _____ feet below top of ground. <u>317 1/2"</u> <u>4"</u>	<u>Sand</u>		<u>344</u>
(4) Cased to: <u>196'</u> , Size <u>2"</u>	<u>Bottom</u>		<u>545</u>
(5) Screen: Size <u>2"</u> , Length <u>40'</u>			
(6) Were any formations sealed against pollution? <input checked="" type="checkbox"/> yes, <input type="checkbox"/> no.			
If YES depth of formation: <u>260</u>			
Why: <u>Surf + sand</u>			
Drillers Remarks: <u>Sub</u>			
<u>out in pasture - dairy barn</u>			
<u>Ruff dairy #2</u>			
<u>195 ELEV 340</u>			

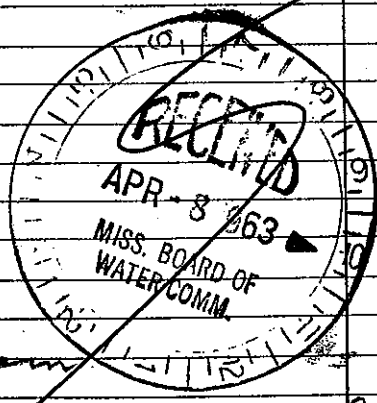

Mail this copy to Board of Water Commissioners 429 Miss. St. Jackson, Miss

Well No.

(Use Back Side)