

LEE
K 46
5-2-63

MISSISSIPPI BOARD OF WATER COMMISSIONERS


WATER WELL DRILLERS LOG

Date: 5/2, 1963, Driller: HERNDON WELL & SUPPLY CO. P.O. BOX 42 County Lee
SHUMPERT SHANNON, MISSISSIPPI

(1) Owner of Land	Description & Color of Materials	Thick-ness Feet	Depth Feet
<u>Shumpert Shannon</u> (Name) <u>Rt 4 Topola Miss.</u> (Address)	<u>Surface sand & clay</u>		<u>0</u>
(2) Location: $\frac{1}{4}$, $\frac{1}{4}$, Sec. <u>24</u> T. <u>10 S</u> R. <u>5 E</u> <u>1/2</u> miles <u>W</u> of <u>Verona</u> (distance) (direction) (Nearest Town)	<u>Blue rock</u>		<u>35</u>
(3) Topography: <u>flat</u> (Hilly) (Flat) (Level)	<u>Sand</u>		<u>340</u>
(4) Purpose of Well: <u>Domestic</u> (Domestic Irrigation Municipal, Industrial, Other)	<u>Bottom</u>		<u>480</u>

Information upon completion of well:

(1) Diameter 5 inches.
 (2) Total Depth 480 feet.
 (3) Water Level 140 feet below top of ground.
 (4) Cased to 37' 3", Size 5".
 (5) Screen: Size —, Length —.
 (6) Were any formations sealed against pollution?
 yes, no.
 If YES depth of formation 35'
 Why surface of sand
 Drillers Remarks: sub
198 ELEV 350

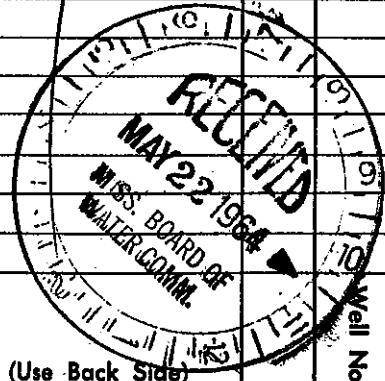

(Use Back Side)

Mail this copy to Board of Water Commissioners 429 Miss. St. Jackson, Miss