

LEE MISSISSIPPI BOARD OF WATER COMMISSIONERS

K 47
6-1-63

WATER WELL DRILLERS LOG

Date: 6-1, 1963, Driller: HERNDON WELL & SUPPLY CO.
P.O. BOX 42 County Lee
SHANNON, MISSISSIPPI

(1) Owner of Land: <u>Max Wade</u> (Name)	Description & Color of Materials Sand, Clay, Red Clay, Shell, etc.	Thick- ness Feet	Depth Feet
<u>At 4 Tupelo, Miss</u> (Address)	<u>Surface mud and clay</u>		<u>0</u>
(2) Location: <u>1/4, 1/4, Sec. 23 T. 10 S. R. 5 E</u> <u>1</u> miles <u>W</u> , of <u>Verona</u> (distance) (direction) (Nearest Town)	<u>Blue mud</u>		<u>36</u>
(3) Topography: <u>Flat</u> (Hilly) (Flat) (Level)	<u>mud</u>		<u>360</u>
(4) Purpose of Well: <u>Domestic</u> (Domestic Irrigation Municipal, Industrial, Other)	<u>Bottom</u>		<u>500</u>

Information upon completion of well:


- (1) Diameter 5 inches.
- (2) Total Depth 500 feet.
- (3) Water Level 142 feet below top of ground.
- (4) Cased to 38', Size 5"
- (5) Screen: Size , Length
- (6) Were any formations sealed against pollution?
 yes, no.

If YES depth of formation 36'

Why Surface mud and mud

Drillers Remarks:

199 ELEV 315

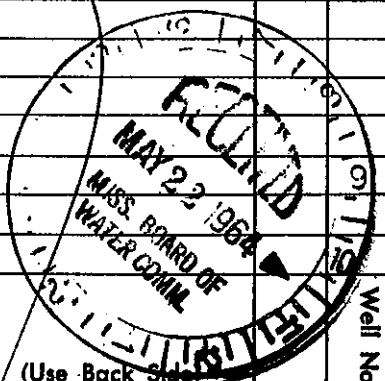

(Use Back Side)

Mail this copy to Board of Water Commissioners 429 Miss. St. Jackson, Miss.