

MISSISSIPPI BOARD OF WATER COMMISSIONERS

LEE
K 49
3-30-63

WATER WELL DRILLERS LOG



Date March 30, 1963, Driller HERNDON WELL & SUPPLY CO County Lee

P.O. BOX 42
SHANNON, MISSISSIPPI

	Description & Color of Materials Sand, Clay, Red Clay, Shell, etc.	Thick- ness Feet	Depth Feet
(1) Owner of Land <u>Dale S. Kelley Christian</u> <u>Church Dale Taylor</u> (Name) (Address)	surface sand & clay		0
(2) Location: <u>SE 1/4, SW 1/4, Sec 34 T 125 R 5E</u>	Blue rock		20
<u>4</u> miles <u>NW</u> of <u>Shannon</u> (distance) (direction) (Nearest Town)	sand		360
(3) Topography: <u>flat hill side</u> (Hilly) (Flat) (Level)			
(4) Purpose of Well: <u>Domestic</u> (Domestic Irrigation Municipal, Industrial, Other)	Bottom		480

Information upon completion of well:

- (1) Diameter 4 inches.
- (2) Total Depth 480 feet.
- (3) Water Level 120 feet below top of ground.
- (4) Cased to 25', Size 4"
- (5) Screen: Size _____, Length _____
- (6) Were any formations sealed against pollution?
 yes, _____ no.
- If YES depth of formation 20 ft.
- Why surface & sand
- Drillers Remarks: _____

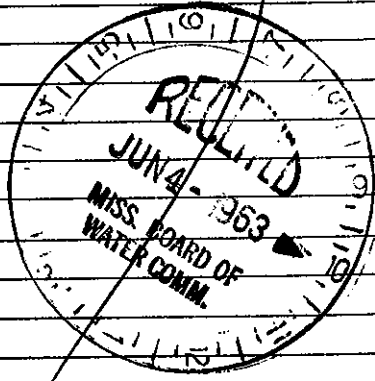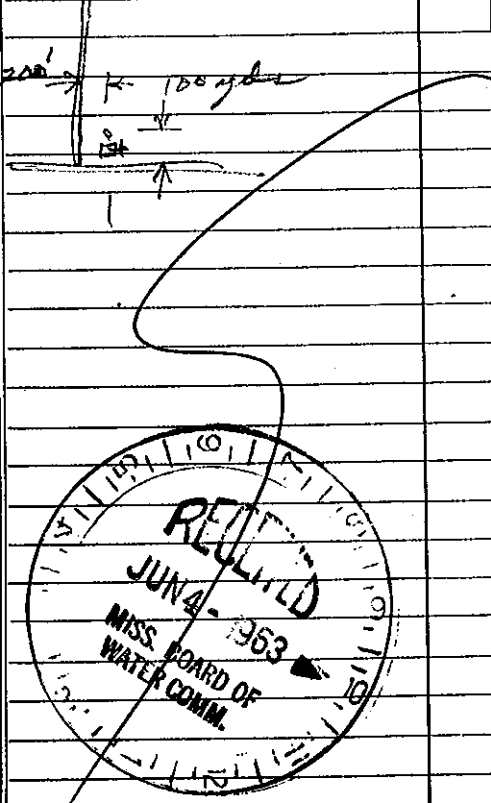

197 ELEV 300

(Use Back Side)

Well No.

Mail this copy to Board of Water Commissioners 429 Miss. St. Jackson, Miss