

LEE MISSISSIPPI BOARD OF WATER COMMISSIONERS

K 50

4-5-65

WATER WELL DRILLERS LOG

Date: April 15, 1965, Driller: Herndon-Homan Well & Supply, Inc. P. O. Box 42 County Lee SHANNON, MISSISSIPPI 38868


(1) Owner of Land: Wade Spryges (Name) At 3 Tupelo, Miss. (Address) (2) Location: 1/4, 1/4, Sec. 4, T10S, R25E 1 mile W of Tupelo (distance) (direction) (Nearest Town) (3) Topography: Flat (Hilly) (Flat) (Level) (4) Purpose of Well: Domestic (Domestic Irrigation Municipal, Industrial, Other)

Table with 3 columns: Description & Color of Materials, Thickness Feet, Depth Feet. Rows include: sand + clay 0-5, lime rock 5-25, blue clay 25-180, sand 180-200, blue clay 200-480, sand 480-600, bottom 600.

Information upon completion of well:

(1) Diameter 5 inches. (2) Total Depth 600 feet. 114.85, 2/21/67 (3) Water Level 110 feet below top of ground. (4) Cased to 29' 2", Size 5" (5) Screen: Size, Length (6) Were any formations sealed against pollution? yes, no.

If YES depth of formation 25' Why surface + sand Drillers Remarks: slick

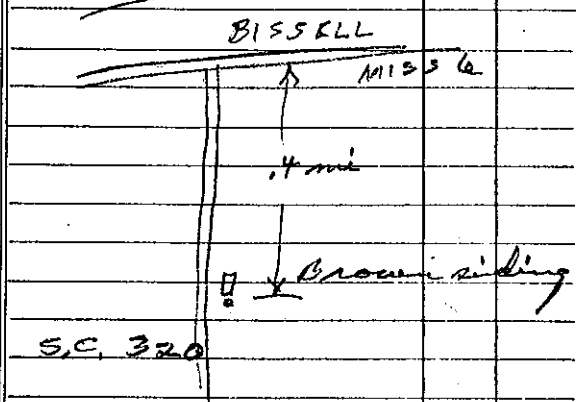

(Use Back Side)

Well No.

200 ELEU 305 retain this copy for your office files.