

LEE MISSISSIPPI BOARD OF WATER COMMISSIONERS

K 51

WATER WELL DRILLERS LOG

10-10-65

Herndon-Homan Well & Supply, Inc.

Date: Oct 10, 1965 Driller: P. O. Box 42 County: Lee
SHANNON, MISSISSIPPI 38668

(1) Owner of Land: T. R. Murphy
 (Name)
42 Shannon, Miss.
 (Address)

(2) Location: 1/4, 1/4, Sec. 25 T10 R6E
0 miles S of Vernon
 (distance) (direction) (Nearest Town)

(3) Topography: Hilly
 (Hilly) (Flat) (Level)

(4) Purpose of Well: Domestic
 (Domestic Irrigation
 Municipal, Industrial, Other)

| Description & Color of Materials Sand, Clay, Red Clay, Shell, etc. | Thick- ness Feet | Depth Feet |
|---|------------------------|---------------|
| <u>red clay</u> | <u>0-15</u> | |
| <u>blue clay</u> | <u>15-280</u> | |
| <u>sand</u> | <u>280-400</u> | |
| <u>Bottom</u> | <u>400</u> | |

Information upon completion of well:

(1) Diameter 4 inches.

(2) Total Depth 400 feet.

(3) Water Level 110 feet below top of ground.

(4) Cased to 17' 6", Size 4"


(5) Screen: Size —, Length —

(6) Were any formations sealed against pollution?
 yes, no.

If YES depth of formation 15'

Why surface sand

Drillers Remarks: _____

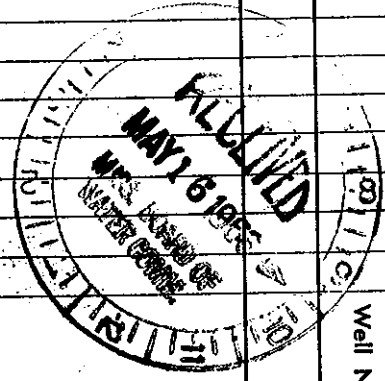

201 ELEV 300

(Use Back Side)

Well No.

Mail this copy to Board of Water Commissioners 429 Miss. St. Jackson, Mis.