

LEE  
K 53  
10-16-60

### WATER WELL DRILLERS LOG

~~K 200~~

Date: Oct 16, 1960, Driller: SHANNON, MISS. County Lowe

(Name)



| (1) Owner of Land: <u>Cleare McCaughey</u><br>(Name)   | Description & Color of Materials<br>Sand, Clay, Red Clay, Shell, etc. | Thick-<br>ness<br>Feet | Depth<br>Feet |
|--|---|------------------------|---------------|
| <u>At 3 Tupelo Miss.</u><br>(Address)  | <u>Sand &amp; clay</u>  |                        | <u>23</u>     |
| (2) Location: <u>NW 1/4, SE 1/4, Sec. 21 T12S, R4E</u><br><u>4</u> miles <u>West</u> , of <u>Verona</u><br>(distance) (direction) (Nearest Town) | <u>Blue Rock</u>  |                        |               |
| (3) Topography: <u>Flat Hill top</u><br>(Hilly) (Flat) (Level)   | <u>Sand</u>   |                        | <u>450</u>    |
| (4) Purpose of Well: <u>Home Use</u><br>(Domestic Irrigation<br>Municipal, Industrial, Other)  | <u>Bottom</u>   |                        | <u>560</u>    |

1st house on R north

#### Information upon completion of well:

- (1) Diameter 4 inches.
- (2) Total Depth 560 feet.
- (3) Water Level 130 feet below top of ground.
- (4) Cased to 25 ft, Size 4 in.
- (5) Screen: Size —, Length —
- (6) Were any formations sealed against pollution?  
X yes, — no.

If YES depth of formation 23 ft  
 Why Surface & Sand  
 Drillers Remarks: Cylinder pump

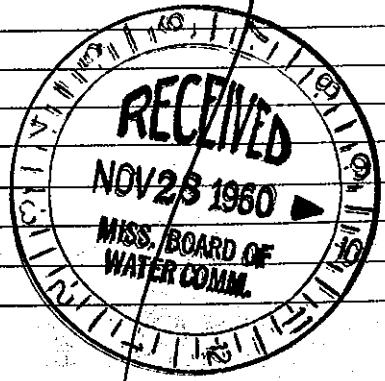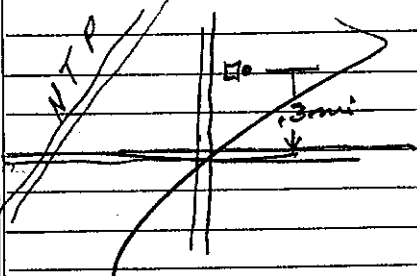

(Use Back Side)

Well No.

181 ELEV 335

Retain this copy for your office files.