

MISSISSIPPI BOARD OF WATER COMMISSIONERS

K 54

WATER WELL DRILLERS LOG

Date: 10/7, 1966, Driller: E. W. King County: See

(Name)


(1) Owner of Land: For Lease & Woodlot  
 (Name)  
Claywood Subdivision  
HOWARD DAVENPORT  
 (Address)

(2) Location:  $\frac{1}{4}$ , SE  $\frac{1}{4}$ , Sec. 2 T10R5  
5 E  
1 miles SW of Lupido  
 (distance) (direction) (Nearest Town)

(3) Topography: Hilly  
 (Hilly) (Flat) (Level)

(4) Purpose of Well: Domestic  
 (Domestic Irrigation  
 Municipal, Industrial, Other)

Description & Color of Materials Sand, Clay, Red Clay, Shell, etc.	Thick- ness Feet	Depth Feet
<u>red clay</u>	<u>8</u>	<u>8</u>
<u>lime rock</u>	<u>10</u>	<u>18</u>
<u>Blue sand</u>	<u>357</u>	<u>375</u>
	<u>140</u>	<u>515</u>

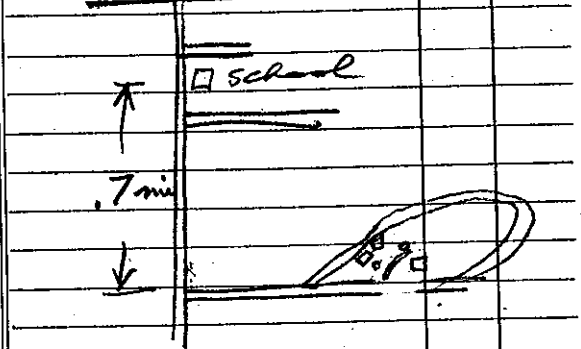

Information upon completion of well:

(1) Diameter 4 inches.

(2) Total Depth 515 feet.  
145.5 3/2/67

(3) Water Level 172 feet below top of ground.

(4) Cased to 253 ft., Size 4 in.

(5) Screen: Size \_\_\_\_\_, Length \_\_\_\_\_

(6) Were any formations sealed against pollution?  
 \_\_\_\_\_ yes, \_\_\_\_\_ no.

If YES depth of formation \_\_\_\_\_

Why \_\_\_\_\_

Drillers Remarks: off S. Thomas St  
hook < 1 H.P.

352 ELEV 330

(Use Back Side)

Well No.