

LEE MISSISSIPPI BOARD OF WATER COMMISSIONERS

~~X2K~~ 56 WATER WELL DRILLERS LOG

5-1-63

Date: 5/1, 1963, Driller: RANDON WELL & SUPPLY Co. County Lee

P. O. BOX 42 SHANNON, MISSISSIPPI

(1) Owner of Land: Charles Kelly (Name)	Description & Color of Materials Sand, Clay, Red Clay, Shell, etc.	Thick- ness Feet	Depth Feet
At 3 Topols, Miss. (Address)	surface sand & clay		0
(2) Location: SE 1/4, NW 1/4, Sec. 234, T. 105, R. 5E 4 miles SW of Verona, (distance) (direction) (Nearest Town)	blue sand	5	12
(3) Topography: flat hill top (Hilly) (Flat) (Level)	sand	6	18
(4) Purpose of Well: Domestic (Domestic Irrigation Municipal, Industrial, Other)	bottom	6	24



Information upon completion of well:

- (1) Diameter 4 inches.
- (2) Total Depth 24 feet.
- (3) Water Level 130 feet below top of ground.
- (4) Cased to 14', Size 4"
- (5) Screen: Size _____, Length _____
- (6) Were any formations sealed against pollution?
 yes, no.

If YES depth of formation 12'

Why surface sand

Drillers Remarks: sand permeable

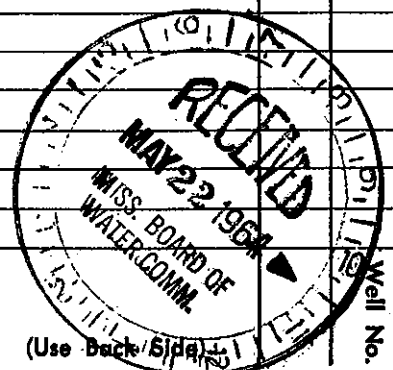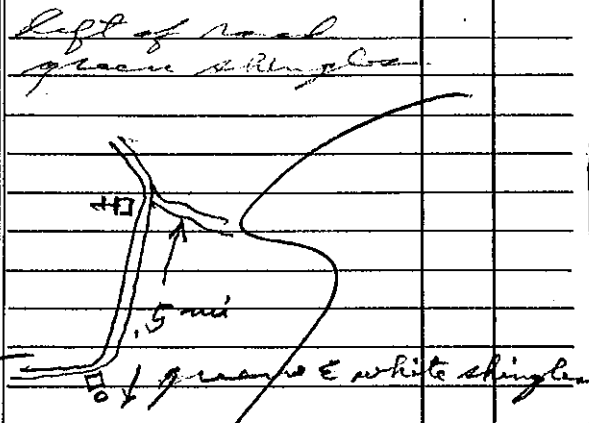

257 ELEV 335

Mail this copy to Board of Water Commissioners 429 Miss. St. Jackson, Miss.