

# WATER WELL DRILLERS LOG


LEE  
 Date: 12-28, 1960, Driller: Ewing Gas Co, County Lee

K57  
 12-28-60  
 (1) Owner of Land: W. L. Jenkins  
 (Name)  
Shannon, Miss.  
 (Address)  
 (2) Location: SE 1/4, NW 1/4, Sec. 34 T10 R3  
 miles \_\_\_\_\_ of \_\_\_\_\_  
 (distance) (direction) (Nearest Town)  
 (3) Topography: \_\_\_\_\_  
 (Hilly) (Flat) (Level)  
 (4) Purpose of Well: Household  
 (Domestic Irrigation  
 Municipal, Industrial, Other)

Description & Color of Materials Sand, Clay, Red Clay, Shell, etc.	Thick- ness Feet	Depth Feet	

**Information upon completion of well:**

(1) Diameter 4 inches.  
 (2) Total Depth 537 feet.  
 (3) Water Level 117 feet below top of ground.  
 (4) Cased to 19', Size \_\_\_\_\_  
 (5) Screen: Size \_\_\_\_\_, Length \_\_\_\_\_  
 (6) Were any formations sealed against pollution?  
 yes, \_\_\_\_\_ no.  
 If YES depth of formation 19'  
 Why \_\_\_\_\_  
 Drillers Remarks: \_\_\_\_\_  
206 ELEV 345

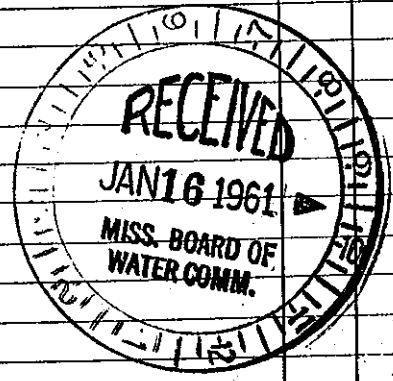

Well No.

(Use Back Side)

Mail this copy to Board of Water Commissioners 429 Miss. St. Jackson, Miss