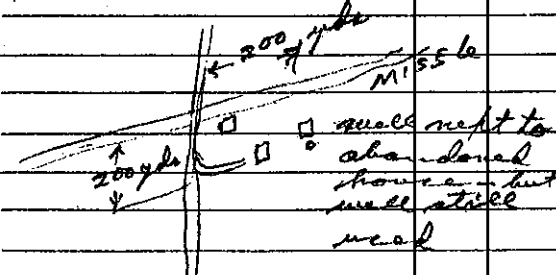



MISSISSIPPI BOARD OF WATER COMMISSIONERS

LEE

WATER WELL DRILLERS LOG

Date: 7-8-60, 1960, Driller: O. C. Webb County Lee
 (Name)

(1) Owner of Land:	Description & Color of Materials Sand, Clay, Red Clay, Shell, etc.	Thick- ness Feet	Depth Feet
(Name) <u>Gray Nickles</u>	<u>soil to 12 ft</u>		
(Address) <u>Supelo miss</u>	<u>Blue Rock to</u>		
(2) Location: <u>1/4</u> , <u>1/4</u> , Sec. <u>5</u> ^{103 E} <u>R5</u>	<u>485 ft water</u>		
(3) Topography: <u>7</u> miles <u>south</u> of <u>Supelo</u> (distance) (direction) (Nearest Town)	<u>sand to 620</u>		
(4) Purpose of Well: <u>farm</u> (Domestic Irrigation, Municipal, Industrial, Other)			
Information upon completion of well:			
(1) Diameter <u>4</u> inches.			
(2) Total Depth <u>620</u> feet.			
(3) Water Level <u>165</u> feet below top of ground.			
(4) Cased to <u>22</u> , Size <u>4"</u>			
(5) Screen: Size <u>0</u> , Length _____			
(6) Were any formations sealed against pollution? _____ yes, <u>0</u> no.			
If YES depth of formation _____			
Why _____			
Drillers Remarks: _____			
<u>258 ELEV 380</u>			

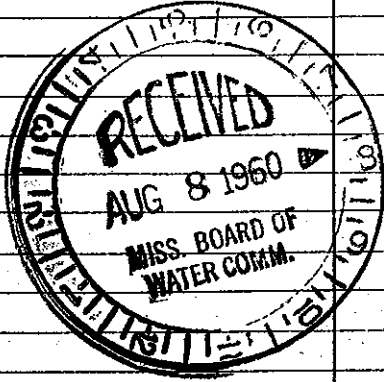

(Use Back Side)

Well No.

Mail this copy to Board of Water Commissioners 429 Miss. St. Jackson, Miss