

Lee

K 60

3-66

MISSISSIPPI BOARD OF WATER COMMISSIONERS

WATER WELL DRILLERS LOG


Herndon-Homan Well & Supply, Inc.

Date: March 15 1966, Driller: SHANNON, MISSISSIPPI 38668, County Lee

Log form sections: (1) Owner of Land: N.E. DACAS, Pt 3 Tunelo, Miss.; (2) Location: SW 1/4, SW 1/4, Sec. 4, T14 R5, 1 mile SW of Tunelo; (3) Topography: High; (4) Purpose of Well: Domestic

Information upon completion of well: (1) Diameter 5 inches; (2) Total Depth 580 feet; (3) Water Level 103 feet below top of ground; (4) Cased to 14 1/2", Size 5"; (5) Screen: Size None; (6) Were any formations sealed against pollution? Yes

Table with 4 columns: Description & Color of Materials, Thickness Feet, Depth Feet. Entries include: surface sand & clay (10 ft), blue rock (430 ft), Sand (40 ft), Bottom (580 ft), Big brick house.

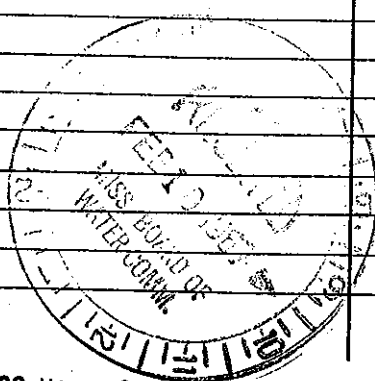

File this copy to Board of Water Commissioners 429 Miss. St. Jackson, Miss.

382 ELEV 300