

Lee K61
10

12-66 MISSISSIPPI BOARD OF WATER COMMISSIONERS

WATER WELL DRILLERS LOG

Herndon-Homan Well Supply, Inc.

Date: Feb 6, 1965, Driller: P. O. Box 424 County Lee
(When well drilled) **SHANNON, MISSISSIPPI 38868** (Where well is located)

(1) Owner of Land:	Description & Color of Materials Sand, Clay, Red Clay, Shell, etc.	Thick- ness Feet	Depth Feet
<u>John Burt</u> (Name)	<u>surface clay sand</u>	<u>30</u>	<u>30</u>
<u>At 3 Topelo, Miss.</u> (Address)	<u>blue clay</u>	<u>570</u>	<u>600</u>
(2) Location: <u>SW 1/4, SE 1/4, Sec. 28 T10R5</u>	<u>Sand</u>	<u>120</u>	<u>520</u>
<u>4</u> miles <u>SW</u> , of <u>Verona</u> (distance) (direction) (Nearest Town)	<u>bottom</u>	<u>520</u>	
(3) Topography: <u>flat</u> (Hilly) (Flat) (Level)			
(4) Purpose of Well: <u>None</u> (Domestic Irrigation Municipal, Industrial, Other)			

Information upon completion of well:

- (1) Diameter 5 inches.
- (2) Total Depth 520 feet.
- (3) Water Level 122 feet below top of ground.
- (4) Cased to 34' 8", Size 5"
- (5) Screen: Size none, Length _____
- (6) Were any formations sealed against pollution?
 yes, _____ no.

If YES depth of formation 30'


Why surface + sand

Drillers Remarks: _____

Yield in gpm: 5

Size pump: 1/2 HP submersible

Type power: electric

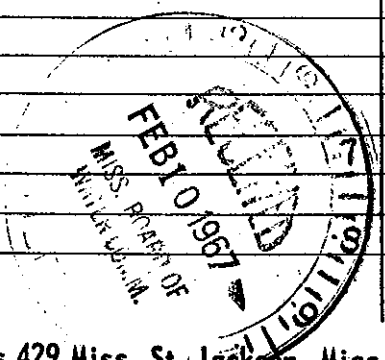

Mail this copy to Board of Water Commissioners 429 Miss. St. Jackson, Miss.
384 ELEV 320