

LEE

MISSISSIPPI BOARD OF WATER COMMISSIONERS

K 65

WATER WELL DRILLERS LOG

K302

7-7-60 CODED

Date: 7-7, 1960, Driller: O. C. Webb County Lee

(Name)


(1) Owner of Land:	Description & Color of Materials Sand, Clay, Red Clay, Shell, etc.	Thick- ness Feet	Depth Feet
Oscar Green (Name) Supelo Miss (Address)	soil to 20ft		
(2) Location: 1/4, 1/4, Sec. 2 T9 R5 E 6 miles West of Supelo (distance) (direction) (Nearest Town)	clay to 30ft		
(3) Topography: <input checked="" type="checkbox"/> (Hilly) <input type="checkbox"/> (Flat) <input type="checkbox"/> (Level)	Blue Rock to		
(4) Purpose of Well: <input checked="" type="checkbox"/> (Domestic Irrigation) <input type="checkbox"/> (Municipal, Industrial, Other)	500ft water		
	sand to 641		

Information upon completion of well:

- (1) Diameter 4 inches.
- (2) Total Depth 641 feet.
- (3) Water Level 147 feet below top of ground.
- (4) Cased to 42ft, Size 4"
- (5) Screen: Size 20, Length
- (6) Were any formations sealed against pollution?  
yes, no

If YES depth of formation  
Why  
Drillers Remarks:

CODED

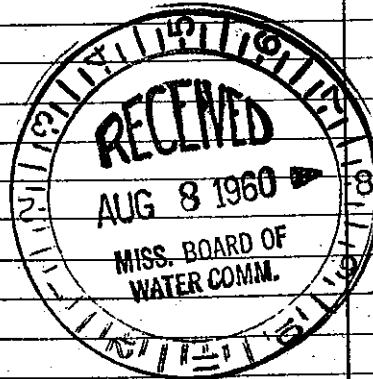

Well No. K302

(Use Back Side)