

LEE
K67
9-12-62 CODED

MISSISSIPPI BOARD OF WATER COMMISSIONERS

WATER WELL DRILLERS LOG


Date: SEPT 12 1962, Driller: OTTIS Webb, JR. County LEE
(Name)

(1) Owner of Land: <u>L. D. HANCOCK</u> (Name)	Description & Color of Materials Sand, Clay, Red Clay, Shell, etc.	Thick- ness Feet	Depth Feet
<u>TUPELO, MISS</u> (Address)	CLAY	0	15
(2) Location: <u>1/4</u> , <u>3 E</u> <u>1/4</u> , Sec. <u>3 T10R5</u>	LIMESTONE	15	120
<u>1</u> miles <u>E</u> of <u>TUPELO</u> (distance) (direction) (Nearest Town)	SAND WITH BLUE MARL INTERMIXED	120	190
(3) Topography: <u>K</u> (Hilly) (Flat) (Level)	BLUE MARL	190	380
(4) Purpose of Well: <u>DOMESTIC</u> (Domestic Irrigation Municipal, Industrial, Other)	SAND	380	515
	BLUE MARL	515	528

Information upon completion of well:

- (1) Diameter 4 inches.
- (2) Total Depth 528 feet.
- (3) Water level APPROX. 150 feet below top of ground.
- (4) Cased to 211', Size 4"
- (5) Screen: Size _____, Length _____
- (6) Were any formations sealed against pollution?
_____ yes, X no.

If YES depth of formation _____
Why _____
Drillers Remarks: _____

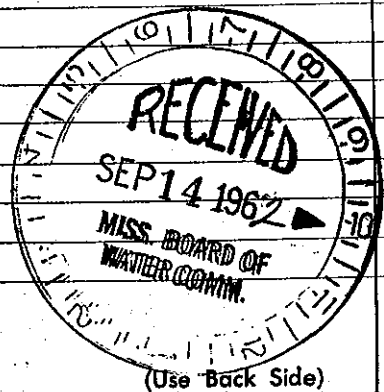

140

Well No.