

Lee
K68
8-66

CODED

MISSISSIPPI BOARD OF WATER COMMISSIONERS

WATER WELL DRILLERS LOG

Date Aug 4, 1966, Driller: Herndon-Homan Well & Supply, Inc.
(When well drilled) P. O. Box 42
SHANNON, MISSISSIPPI 38868 County Lee
(Name) (Where well is located)

(1) Owner of Land: Bennie Jackson
(Name)
At 3 Tupelo Miss
(Address)
(2) Location: SW 1/4, NE 1/4, Sec 34 T10 R5
2 1/2 miles SW of Verona
(distance) (direction) (Nearest Town)
(3) Topography: Hilly
(Hilly) (Flat) (Level)
(4) Purpose of Well: Domestic
(Domestic Irrigation
Municipal, Industrial, Other)


Description & Color of Materials Sand, Clay, Red Clay, Shell, etc.	Thick- ness Feet	Depth Feet
<u>yellow sand clay</u>	<u>15</u>	<u>15</u>
<u>Blue clay</u>	<u>365</u>	<u>380</u>
<u>SE sand</u>	<u>120</u>	<u>500</u>

Information upon completion of well:

(1) Diameter 5 inches.
(2) Total Depth 500 feet.
(3) Water Level 130 feet below top of ground.
(4) Cased to 17', Size 5"
(5) Screen: Size none, Length _____
(6) Were any formations sealed against pollution?
yes, _____ no.

If YES depth of formation 15'
Why surface + sand
Drillers Remarks:
Yield in gpm: 5 gpm
Size pump: 1/2 HP sub
Type power: Electric

CODED

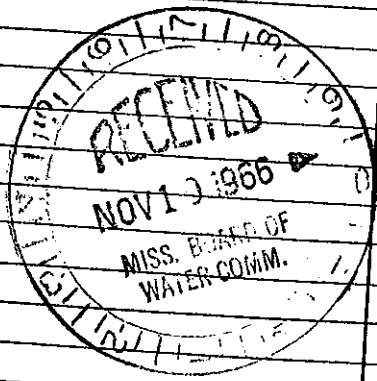

Mail this copy to Board of Water Commissioners 429 Miss. St. Jackson, Miss.
383