

Lee
K 69

8-65

MISSISSIPPI BOARD OF WATER COMMISSIONERS

CODED
CODED
CODED

WATER WELL DRILLERS LOG


Date: Nov 16, 1965 (When well drilled) Driller: Herndon-Homan Well & Supply, Inc.
P. O. Box 42
SHANNON, MISSISSIPPI Lee county (Where well is located)

(1) Owner of Land: Cooley Construction (Name)
 Contractor: Tupelo, Miss (Address)
 (2) Location: W 1/4, SE 1/4, Sec 2 T10RS
1/2 miles South of Tupelo (Nearest Town)
 (3) Topography: Flat (Hilly) (Flat) (Level)
 (4) Purpose of Well: Domestic (Domestic Irrigation, Municipal, Industrial, Other)

Information upon completion of well:

(1) Diameter 5 inches.
 (2) Total Depth 480 feet.
 (3) Water Level 185' feet below top of ground.
 (4) Cased to 24 1/2", Size 5"
 (5) Screen: Size NONE, Length _____
 (6) Were any formations sealed against pollution?
 yes, no.
 If YES depth of formation 20'
 Why Surface sand
 Drillers Remarks: _____
 Yield in gpm: 5
 Size pump: 3/4
 Type power: Electric

Description & Color of Materials Sand, Clay, Red Clay, Shell, etc.	Thick- ness Feet	Depth Feet
<u>surface sand & clay</u>	<u>20</u>	<u>20</u>
<u>Blue clay</u>	<u>156</u>	<u>176</u>
<u>sand</u>	<u>20</u>	<u>196</u>
<u>Blue clay</u>	<u>164</u>	<u>360</u>
<u>sand</u>	<u>120</u>	<u>480</u>

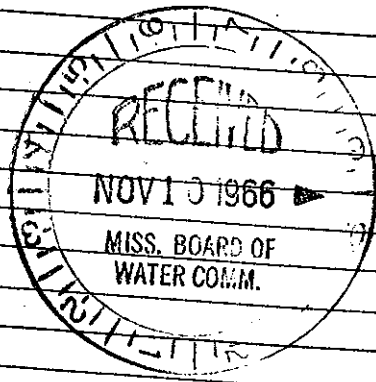

if this copy to Board of Water Commissioners 429 Miss. St. Jackson, Miss.
381