

Lee
K72
7-66

INDEXED
INDEXED
MISSISSIPPI BOARD OF WATER COMMISSIONERS

WATER WELL DRILLERS LOG


Date: July 8, 1966, Driller: Herndon-Homan Well & Supply, Inc.
(When well drilled) P. O. Box 42 County Lee
SHANNON, MISSISSIPPI 38868 (Where well is located)

(1) Owner of Land: <u>Bob Cook</u> <small>(Name)</small>	Description & Color of Materials Sand, Clay, Red Clay, Shell, etc.	Thick- ness Feet	Depth Feet
<u>At 4 Tupelo, Miss.</u> <small>(Address)</small>	<u>surface sand</u>		
(2) Location: <u>SW 1/4, NE 1/4, Sec. 11 T. 18 S. R. 5 E.</u> <u>1/2 miles SW</u> , of <u>Tupelo</u> , <small>(distance) (direction) (Nearest Town)</small>	<u>clay</u>	<u>0-28</u>	
(3) Topography: <u>Flat</u> <small>(Hilly) (Flat) (Level)</small>	<u>Blue clay</u>	<u>28-162</u>	
(4) Purpose of Well: <u>Domestic</u> <small>(Domestic Irrigation Municipal, Industrial, Other)</small>	<u>Sand</u>	<u>162-175</u>	
	<u>Blue clay</u>	<u>175-362</u>	
	<u>Sand</u>	<u>362-480</u>	
	<u>Bottom</u>	<u>480</u>	

Information upon completion of well:

- (1) Diameter 5 inches.
- (2) Total Depth 480 feet.
- (3) Water Level 172' feet below top of ground.
- (4) Cased to 200' 8", Size 5"
- (5) Screen: Size none, Length —
- (6) Were any formations sealed against pollution?
✓ yes, — no.

If YES depth of formation 195'
 Why surface sand
 Drillers Remarks: _____
 Yield in gpm: 5 gpm
 Size pump: 3/4 HP Subi
 Type power: Electric

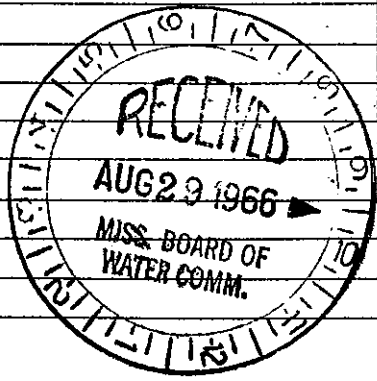

Mail this copy to Board of Water Commissioners 429 Miss. St. Jackson, Miss.