

CODED

MISSISSIPPI
BOARD OF WATER COMMISSIONERS
416 North State Street
Jackson, Mississippi 39201

WATER WELL DRILLERS LOG

LEE
K73
12-67

12/19 1967 Marston-Homan Well & Supply, Inc. Lee
date well completed firm name Box 42 county well located
SEAYNOW, MISSISSIPPI 39201


LANDOWNER:
Antonia's Dining Bar
At & Shannon, Miss
(mailing address)

description of formations encountered	from	to
<u>seam sand clay</u>	<u>0</u>	<u>20</u>
<u>blue clay</u>	<u>20</u>	<u>300</u>
<u>sand</u>	<u>300</u>	<u>420</u>
<u>bedrock</u>	<u>420</u>	

WELL LOCATION:
ec. 36 T. 10 N. R. 5 E
S
3 miles N of SHANNON
distance (direction) (nearest town)

WELL PURPOSE: Drinking Water
(home, irrigation, municipal, industrial)

- WELL COMPLETION DATA:
- diameter (inches) 5"
 - total depth (feet) 420'
 - static water level (feet) 100' below above top of ground.
 - casing steel 23'
(material) (depth)
if telescope see back. (size)
 - screen 12" 2'
(length) (depth to top)
(size) (material)
 - pump 3/4 6
(HP) (yield gpm)
electric
(type power)
 - electric log no
(yes or no)
(organization running log)
 - how well bottom plugged open

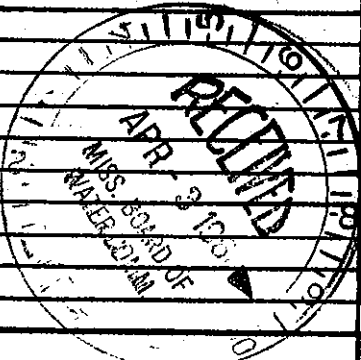

DRILLERS REMARKS: