

LEE
K74
2-65
CODED

MISSISSIPPI BOARD OF WATER COMMISSIONERS

WATER WELL DRILLERS LOG

Date: July 16, 1965, Driller: Marndon-Roman Well & Supply, Inc. County: Lee
P. O. Box 42
SHANNON, MISSISSIPPI 38890

(1) Owner of Land:	Description & Color of Materials Sand, Clay, Red Clay, Shell, etc.	Thick- ness Feet	Depth Feet
<u>Edie Casso</u> (Name)	<u>sand & clay</u>	<u>0</u>	<u>25</u>
<u>At Topelo, Miss.</u> (Address)	blue clay	<u>25</u>	<u>180</u>
(2) Location: <u>SE 1/4, NE 1/4, Sec 14 T 10S R 2E</u>	<u>sand</u>	<u>180</u>	<u>195</u>
<u>2 miles W</u> of <u>Newton</u>	<u>blue clay</u>	<u>15</u>	<u>358</u>
(distance) (direction) (Nearest Town)	<u>sand</u>	<u>360</u>	<u>480</u>
(3) Topography: <u>Flat</u>	<u>Bottom</u>	<u>480</u>	
(Hilly) (Flat) (Level)			
(4) Purpose of Well: <u>Domestic</u>			
(Domestic Irrigation Municipal, Industrial, Other)			

Information upon completion of well:

(1) Diameter 4 inches.

(2) Total Depth 480 feet.

(3) Water Level 140 feet below top of ground.

(4) Cased to 221'6", Size 4"


(5) Screen: Size —, Length —

(6) Were any formations sealed against pollution?
 yes, no.

If YES depth of formation 195'

Why Surface sand

Drillers Remarks:

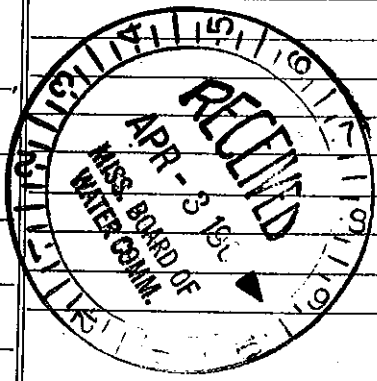

tain this copy for your office files.

(Use Back Side)

Well No.