

See
K
6-66 2000

MISSISSIPPI BOARD OF WATER COMMISSIONERS

WATER WELL DRILLERS LOG

Date: 6/25, 1966, Driller: Swing Barco County Geo.

(1) Owner of Land: Bryant Williams
 (Name)
Jasper MS 4
 (Address)

(2) Location: $\frac{1}{4}$, $\frac{1}{4}$, Sec 5 T10 R5
1/2 miles SW of Jasper
 (distance) (direction) (Nearest Town)

(3) Topography: Hilly
 (Hilly) (Flat) (Level)

(4) Purpose of Well: Domestic
 (Domestic Irrigation
 Municipal, Industrial, Other)

Description & Color of Materials Sand, Clay, Red Clay, Shell, etc.	Thick- ness Feet	Depth Feet
<u>Quint clay</u>	<u>0</u>	<u>15</u>
<u>Blue</u>	<u>65</u>	<u>250</u>
<u>Mix Blue & Sand</u>	<u>220</u>	<u>300</u>
<u>Sand</u>	<u>350</u>	<u>474</u>

Information upon completion of well:

(1) Diameter 4 inches.

(2) Total Depth 474 feet.

(3) Water Level 115 feet below top of ground.

(4) Cased to 214, Size 4 inches.


(5) Screen: Size —, Length —.

(6) Were any formations sealed against pollution?
yes, no.

If YES depth of formation 214

Why —

Drillers Remarks: —

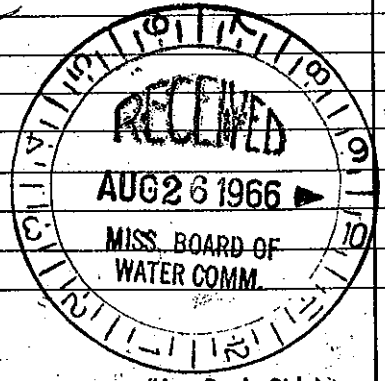

(Use Back Side)

Well No.