

*See*  
*L*  
*8-66*

MISSISSIPPI BOARD OF WATER COMMISSIONERS

WATER WELL DRILLERS LOG

Date: *8/13*, 19*66*, Driller: *Ewing Sisco* County *See*  
(Name)

(1) Owner of Land:	Description & Color of Materials Sand, Clay, Red Clay, Shell, etc.	Thick- ness Feet	Depth Feet
<i>Finley Williams</i> (Name)	<i>Joint clay</i>	<i>0</i>	<i>20</i>
<i>Jupelo Rt. 3</i> (Address)	<i>Blue clay</i>	<i>20</i>	<i>330</i>
(2) Location: $\frac{1}{4}$ , $\frac{1}{4}$ , Sec <i>29 to R 6</i>	<i>very sand &amp; clay</i>	<i>330</i>	<i>530</i>
<i>2 miles SE</i> , of <i>Verona</i> (distance) (direction) (Nearest Town)	<i>Sand</i>	<i>530</i>	<i>612</i>
(3) Topography: <i>hilly</i> (Hilly) (Flat) (Level)			
(4) Purpose of Well: <i>Domestic</i> (Domestic Irrigation Municipal, Industrial, Other)			


Information upon completion of well:

- (1) Diameter *4* inches.
- (2) Total Depth *434* feet.
- (3) Water Level *105* feet below top of ground.
- (4) Cased to *33 ft*, Size *4 in*.
- (5) Screen: Size \_\_\_\_\_, Length \_\_\_\_\_.
- (6) Were any formations sealed against pollution?  
\_\_\_\_\_ yes, \_\_\_\_\_ no.

If YES depth of formation \_\_\_\_\_

Why \_\_\_\_\_

Drillers Remarks: \_\_\_\_\_

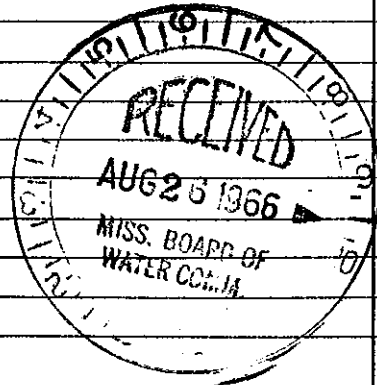

(Use Back Side)

Well No.