

Lee  
L19  
5-66

MISSISSIPPI BOARD OF WATER COMMISSIONERS L19

WATER WELL DRILLERS LOG

Date: 5-3-, 1966, Driller: Layne-Central Co. County Lee  
(Name)

(1) Owner of Land: City of Tupelo  
(Name)  
Tupelo, Mississippi  
(Address)

(2) Location: 1/4, 1/4, Sec. T R  
miles of  
(distance) (direction) (Nearest Town)

(3) Topography: (Hilly) (Flat) (Level)

(4) Purpose of Well: Municipal  
(Domestic Irrigation  
Municipal, Industrial, Other)

Description & Color of Materials Sand, Clay, Red Clay, Shell, etc.	Thick- ness Feet	Depth Feet
Clay	0-10	541'
sand	10-15	
soapstone	15-210	
sandy shale	210-315	
sand & shale st.	315-340	
sand, gravel & shale sts.	340-384	
shale	384-472	
sand-gravel	472-487	
rock	487-488	
sand-gravel	488-500	
chert	536-545	
hard clay	545-575	

Information upon completion of well:

(1) Diameter 16 inches.

(2) Total Depth 541 feet.

(3) Water Level 84 feet below top of ground.

(4) Cased to 461', Size 16"


(5) Screen: Size 10", Length 70'

(6) Were any formations sealed against pollution?  
X yes, no.

If YES depth of formation 461'

Why

Drillers Remarks:

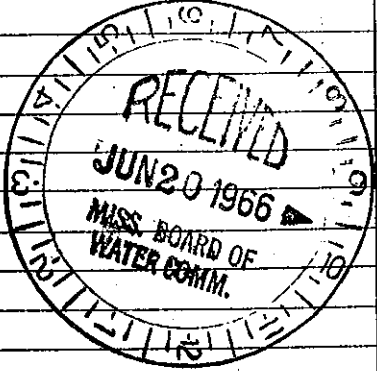

(Use Back Side)

Well No.

359

Mail this copy to Board of Water Commissioners 429 Miss. St. Jackson, Miss