

MISSISSIPPI BOARD OF WATER COMMISSIONERS

WATER WELL DRILLERS LOG

8-8-60

Date: 8-8, 1960, Driller: O. C. Webb County: Lee

(1) Owner of Land: Paul Woods
(Name)

Plantersville Miss
(Address)

(2) Location: 1/4, 1/4, Sec. 15, T. 10 R. 6
1/4 miles East of Plantersville
(distance) (direction) (Nearest Town)

(3) Topography: (Hilly) (Flat) (Level)

(4) Purpose of Well: (Domestic Irrigation, Municipal, Industrial, Other)

Description & Color of Materials
Sand, Clay, Red Clay, Shell, etc. Thickness Feet Depth Feet

Soil to 15 ft
Blue Rock to 220 ft. water
Rock 6 in water sand to 320 ft

Information upon completion of well:

(1) Diameter: 4 inches.

(2) Total Depth: 320 feet.

(3) Water Level: 80 feet below top of ground.

(4) Cased to 22, Size 4'



(5) Screen: Size, Length

(6) Were any formations sealed against pollution?
yes, no.

If YES depth of formation

Why

Drillers Remarks:

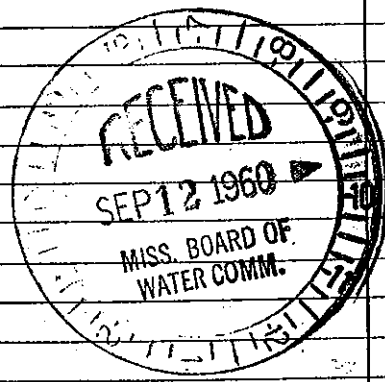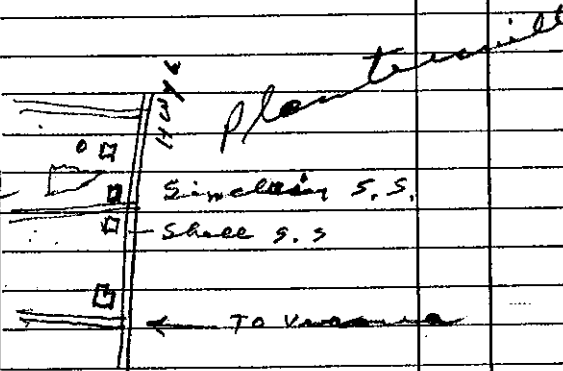

White Board & Rotten
203 ELEV 280

(Use Back Side)

Well No. L301

Mail this copy to Board of Water Commissioners 429 Miss. St. Jackson, Miss