


LEE
 1263/17, 1962, Driller: Jane Fowler County
 3-17-62 (Name) Lee

(1) Owner of Land: THOMAS PRENTICE
 (Name)
Planterville
 (Address)
 (2) Location: 23 1/4, 1/4, Sec. 14 14 SR 6E
4 miles E, of Planterville
 (distance) (direction) (Nearest Town)
 (3) Topography: Hilly
 (Hilly) (Flat) (Level)
 (4) Purpose of Well: DOMESTIC
 (Domestic Irrigation
 Municipal, Industrial, Other)

Description & Color of Materials Sand, Clay, Red Clay, Shell, etc.	Thick- ness Feet	Depth Feet
<u>yellow clay</u>	<u>25'</u>	
<u>blue clay</u>	<u>20'</u>	
<u>sand</u>	<u>155'</u>	

Information upon completion of well:

(1) Diameter 4 inches.
 (2) Total Depth 390' feet.
 (3) Water Level 130' feet below top of ground.
 (4) Cased to 31', Size 4
 (5) Screen: Size _____, Length _____
 (6) Were any formations sealed against pollution?
 yes, _____ no.
 If YES depth of formation _____
 Why _____
 Drillers Remarks: _____
211 ELEV 300

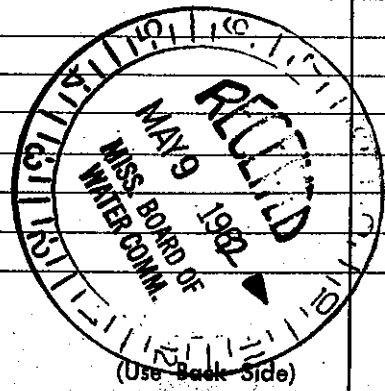

Well No.

Mail this copy to Board of Water Commissioners 429 Miss. St. Jackson, Miss.