

LEE
L 27
5-2-62

MISSISSIPPI BOARD OF WATER COMMISSIONERS

WATER WELL DRILLERS LOG

Date: May 2, 1962, Driller: HERNDON WELL & SUPPLY CO.
P. O. BOX 42 County Lee
SHANNON, MISSISSIPPI

(1) Owner of Land:	Description & Color of Materials Sand, Clay, Red Clay, Shell, etc.	Thick- ness Feet	Depth Feet
<u>Ray Partlow</u> (Name) <u>Plantersville, Miss</u> (Address)	<u>surface sand</u>		<u>0</u>
(2) Location: <u>1/4, 1/4, Sec. 29 T10R7</u> <u>SE</u> miles <u> </u> of <u>Plantersville</u> (distance) (direction) (Nearest Town)	<u>clay</u>		
(3) Topography: <u>Hilly</u> (Hilly) (Flat) (Level)	<u>blue rock</u>	<u>25</u>	
(4) Purpose of Well: <u>Domestic</u> (Domestic Irrigation Municipal, Industrial, Other)	<u>sand</u>	<u>180</u>	
	<u>Bottom</u>	<u>300</u>	


Information upon completion of well:

- (1) Diameter 4 inches.
- (2) Total Depth 300 feet.
130.50
- (3) Water Level 60 feet below top of ground.
- (4) Cased to 30', Size 4"
- (5) Screen: Size , Length
- (6) Were any formations sealed against pollution?
yes, no.

If YES depth of formation 25'
 Why surface & sand

Drillers Remarks:

212 RLEU 350

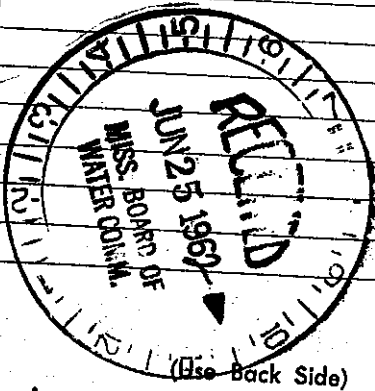

Well No.