

LEE

MISSISSIPPI BOARD OF WATER COMMISSIONERS

L 28

5-25-62

WATER WELL DRILLERS LOG

Date: May 25, 1962, Driller: HERNDON WELL & SUPPLY CO County Lee

A.D.


P. O. BOX 42
SHANNON, MISSISSIPPI

| (1) Owner of Land: <u>Arthur Webb</u> (Name) | Description & Color of Materials Sand, Clay, Red Clay, Shell, etc. | Thick- ness Feet | Depth Feet |
|---|---|------------------------|-------------------------|
| <u>Mr. Tupelo Miss</u> (Address) | <u>Surface sand</u> <u>& clay</u> | | <u>0</u> |
| (2) Location: <u>1/4, 1/4, Sec 10 S</u> T. <u>R. 6 E</u> <u>2 miles NE</u> of <u>Wintersville</u> (distance) (direction) (Nearest Town) | <u>Blue rock</u> <u>Sand</u> | | <u>85</u> <u>280</u> |
| (3) Topography: <u>Hilly</u> (Hilly) (Flat) (Level) | <u>Bottom</u> | | <u>402</u> |
| (4) Purpose of Well: <u>Domestic</u> (Domestic Irrigation Municipal, Industrial, Other) | | | |


Information upon completion of well:

- (1) Diameter 4" inches.
- (2) Total Depth 402 feet.
- (3) Water Level 140' feet below top of ground.
- (4) Cased to 85', Size 5"
- (5) Screen: Size , Length
- (6) Were any formations sealed against pollution?
 yes, no.

If YES depth of formation 85'
Why Surface & sand
Drillers Remarks: sub

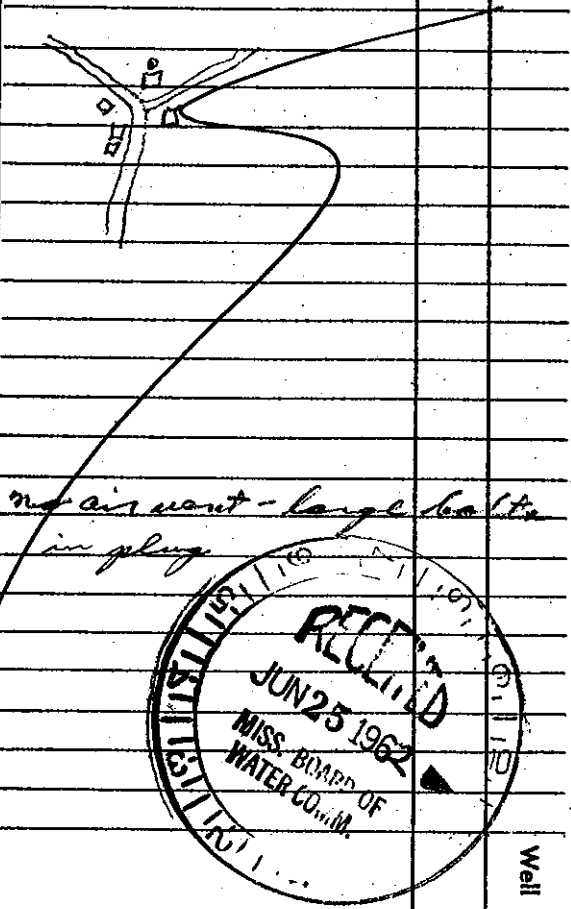

no air vent - large hole
in plug

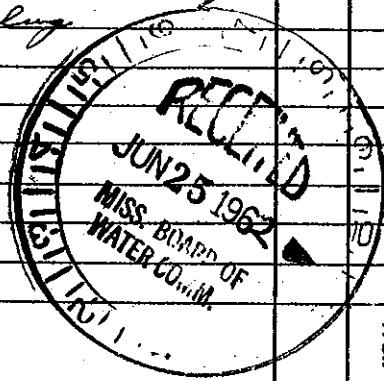

213 ELEV 360

(Use Back Side)

Well No.

Mail this copy to Board of Water Commissioners 429 Miss. St. Jackson, Miss.