

LEE

MISSISSIPPI BOARD OF WATER COMMISSIONERS

L29  
5-31-62

WATER WELL DRILLERS LOG

HERNDON WELL & SUPPLY CO.

Date: May 31, 1962, Driller: P. O. BOX 42 County Lee  
SHANNON, MISSISSIPPI

(1) Owner of Land:	Description & Color of Materials Sand, Clay, Red Clay, Shell, etc.	Thick- ness Feet	Depth Feet
HARRIS ESTES <small>(Name)</small> Rt 1 Plantersville, Miss <small>(Address)</small>	surface sand & clay		0
(2) Location: <sup>SE</sup> SW 1/4, <sup>NE</sup> NE 1/4, Sec 34 T 105 R 6E _____ miles _____ of Plantersville <small>(distance) (direction) (Nearest Town)</small>	Blue rock & sand	30	240
(3) Topography: Hilly <small>(Hilly) (Flat) (Level)</small>	& to		
(4) Purpose of Well: Domestic <small>(Domestic Irrigation Municipal, Industrial, Other)</small>	Bottom	360	

Information upon completion of well:


- (1) Diameter: 4 inches.
- (2) Total Depth: 360 feet.
- (3) Water Level: 60 feet below top of ground.
- (4) Cased to: 36' 6", Size 4"
- (5) Screen: Size \_\_\_\_\_, Length \_\_\_\_\_
- (6) Were any formations sealed against pollution?  
 yes,  no.

If YES depth of formation 30 ft.

Why surface & sand

Drillers Remarks:

214 ELEV 250

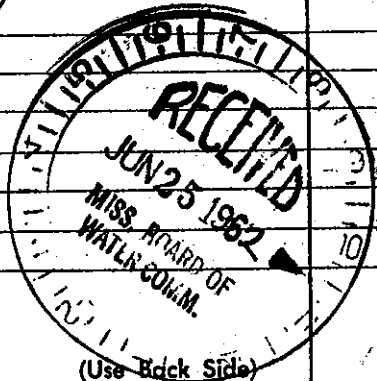

Well No.

Mail this copy to Board of Water Commissioners 429 Miss. St. Jackson, Miss.