

LEE

MISSISSIPPI BOARD OF WATER COMMISSIONERS

L 30

WATER WELL DRILLERS LOG

8-27-63

HERNDON WELL & SUPPLY CO.

Date: 8/27, 1963, Driller: [blank] County Lee

PLANTERSVILLE, MISSISSIPPI

(1) Owner of Land: Diamond Supply  
 (Name)  
Plantersville, Miss  
 (Address)

(2) Location: 1/4, 1/4, Sec. 15 T 10 S R 6 E  
 (distance) 1/2 N of Plantersville  
 (direction) (Nearest Town)

(3) Topography: Hilly  
 (Hilly) (Flat) (Level)

(4) Purpose of Well: Domestic  
 (Domestic Irrigation  
 Municipal, Industrial, Other)

| Description & Color of Materials<br>Sand, Clay, Red Clay, Shell, etc. | Thick-<br>ness<br>Feet | Depth<br>Feet |
|---|------------------------|---------------|
| <u>surface sand &amp; clay</u>  |                        | 0             |
| <u>Blue rock</u>  |                        | 42            |
| <u>Sand</u>   |                        | 220           |
| <u>Bottom</u>   |                        | 360           |

Information upon completion of well:

(1) Diameter 5 inches.

(2) Total Depth 360 feet. 118.7 3 1/4

(3) Water Level 290 feet below top of ground.

(4) Cased to 42', Size 5"



(5) Screen: Size \_\_\_\_\_, Length \_\_\_\_\_

(6) Were any formations sealed against pollution?  
 yes, \_\_\_\_\_ no.

If YES depth of formation 40'

Why surface & sand

Drillers Remarks: open  
2nd house on E

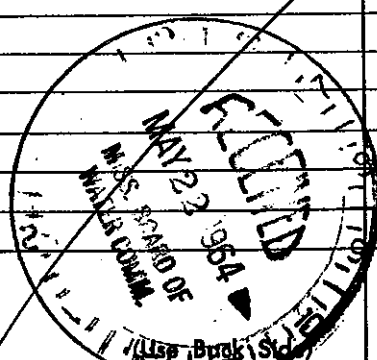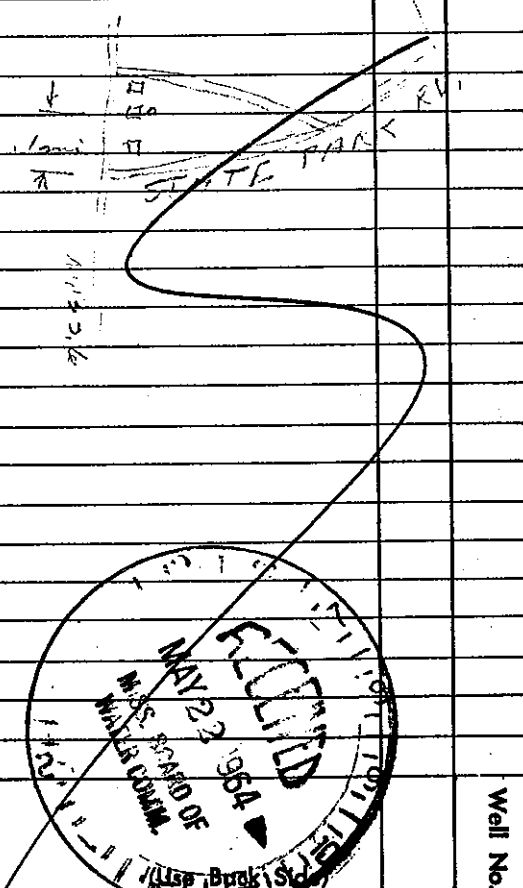

Well No.

Mail this copy to Board of Water Commissioners 429 Miss. St. Jackson, Miss.