

LEE  
L31

MISSISSIPPI BOARD OF WATER COMMISSIONERS

6-16-62

WATER WELL DRILLERS LOG


HERNDON WELL & SUPPLY CO.

Date: June 16, 1962, Driller: SHANNON P. O. BOX 42 County Lee  
FRED COZAKO (1967) (Name) MISSISSIPPI

(1) Owner of Land	Description & Color of Materials Sand, Clay, Red Clay, Shell, etc.	Thick- ness Feet	Depth Feet
<u>Julie Davis</u> (Name) <u>Rt 1 Plantersville, Miss.</u> (Address)	<u>Surface sand &amp; clay</u>		<u>0</u>
(2) Location: <u>23</u> / <u>105</u> Sec <u>4</u> T <u>105</u> R <u>6E</u> <u>2 1/2</u> miles <u>E</u> of <u>Plantersville</u> (distance) (direction) (Nearest Town)	<u>Blue rock</u> <u>8</u>		<u>35</u>
(3) Topography: <u>Hilly</u> (Hills) (Flat) (Level)	<u>Sand</u> <u>+</u>		<u>200</u>
(4) Purpose of Well: <u>Domestic</u> (Domestic Irrigation Municipal, Industrial, Other)	<u>Bottom</u>		<u>320</u>

Information upon completion of well:

- (1) Diameter 4 inches.
- (2) Total Depth 320 feet.
- (3) Water Level 145 feet below top of ground.
- (4) Cased to 37' 10", Size 4 1/2
- (5) Screen: Size —, Length —
- (6) Were any formations sealed against pollution?  
 yes,  no.

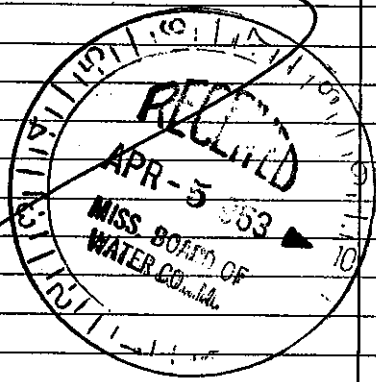

see map  
white vertical ridging

If YES depth of formation 35'

Why Surface & sand

Drillers Remarks:

215 ELEV 370

(Use Back Side)

Well No.

Mail this copy to Board of Water Commissioners 429 Miss. St. Jackson, Miss.