

LEE  
L 32  
9-12-62

MISSISSIPPI BOARD OF WATER COMMISSIONERS

WATER WELL DRILLERS LOG

HERNDON WELL & SUPPLY CO.

Date: Sept 12 1962, Driller: P. O. BOX 42 County Lee  
SHANNON, MISSISSIPPI

(1) Owner of Land: <u>John Robinson</u> (Name)	Description & Color of Materials Sand, Clay, Red Clay, Shell, etc.	Thick- ness Feet	Depth Feet
<u>Rt 1 Plasterville, Miss</u> (Address)	<u>Surface sand &amp; clay</u>		<u>0</u>
(2) Location: <u>1/4, 1/4, Sec. 27 T 10 S R 6 E</u>	<u>Sand</u>		<u>15</u>
<u>2 1/2</u> miles <u>S</u> of <u>Plasterville</u> (distance) (direction) (Nearest Town)	<u>Blue rock</u>		<u>25</u>
(3) Topography: <u>Flat</u> (Hilly) (Flat) (Level)	<u>Sand</u>		<u>140</u>
(4) Purpose of Well: <u>Domestic</u> (Domestic Irrigation Municipal, Industrial, Other)	<u>Bottom</u>		<u>260</u>


Information upon completion of well:

- (1) Diameter 4 inches.
- (2) Total Depth 260 feet.
- (3) Water Level 60 feet below top of ground.
- (4) Cased to 41' 6", Size 4".
- (5) Screen: Size     , Length     .
- (6) Were any formations sealed against pollution?  
 yes,  no.

If YES depth of formation 35 ft  
Why surface & sand  
Drillers Remarks: jet 1/2 H.P.

2nd house on E  
part of lot 10

see 206

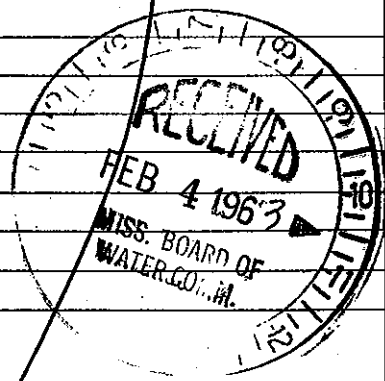

(Use Back Side)

Well No.

219 ELEV 285

Mail this copy to Board of Water Commissioners 429 Miss. St. Jackson, Miss