

LEE

MISSISSIPPI BOARD OF WATER COMMISSIONERS

312

L 35

WATER WELL DRILLERS LOG

6-8-63

HERNDON WELL & SUPPLY CO.

Date: 6-8, 1963, Driller: P. O. BOX 42 County: Lee

SHANNON Name MISSISSIPPI

Breton Driller

(1) Owner of Land:	Description & Color of Materials Sand, Clay, Red Clay, Shell, etc.	Thick- ness Feet	Depth Feet
Breton Business (Name) P.O. 1 Plantersville, Miss. (Address)	surface sand	0	0
(2) Location: 1/4, 1/4, Sec 13 T 105 R 64 E miles E of Plantersville (distance) (direction) (Nearest Town)	2 clay blue rock	5	40
(3) Topography: hilly (Hilly) (Flat) (Level)	sand	5	100
(4) Purpose of Well: Domestic (Domestic Irrigation Municipal, Industrial, Other)	s		


Information upon completion of well:

- (1) Diameter: 5 inches.
- (2) Total Depth: 320 feet.
- (3) Water Level: 140 feet below top of ground.
- (4) Cased to: 44 ft, Size 5 in.
- (5) Screen: Size —, Length —.
- (6) Were any formations sealed against pollution?
 yes, no.

If YES depth of formation: 40'

Why: surface & sand

Drillers Remarks: house trailer

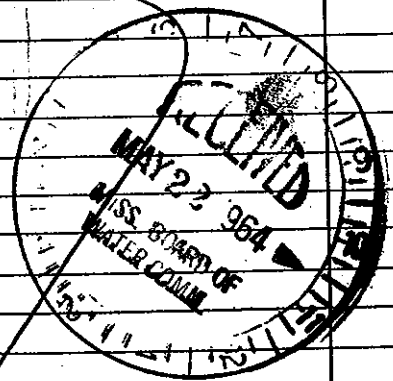

223 ELEV 375

(Use Back Side)

Well No.

Mail this copy to Board of Water Commissioners 429 Miss. St. Jackson, Miss.