

LEE

MISSISSIPPI BOARD OF WATER COMMISSIONERS

WATER WELL DRILLERS LOG

HERNDON WELL & SUPPLY CO.

Date: 7/3, 1963, Driller:

P. O. BOX 42


County: Lee

SHANNON, MISSISSIPPI

(1) Owner of Land:	Description & Color of Materials	Thick-ness Feet	Depth Feet
Paul Shuck (Name) Rt 2 Thomas Miss (Address)	Surface sand & clay		0
(2) Location: 1/4, 1/4, Sec 30 T 103 R 6 E 1 miles S E of Verona, (distance) (direction) (Nearest Town)	Blue rock	6	26
(3) Topography: flat (Hilly) (Flat) (Level)	Sand	6	260
(4) Purpose of Well: Domestic (Domestic Irrigation Municipal, Industrial, Other)	Bottom		400


Information upon completion of well:

- (1) Diameter: 4 inches.
- (2) Total Depth: 400 feet.
- (3) Water Level: 110 feet below top of ground.
- (4) Cased to: 30', Size 4"
- (5) Screen: Size —, Length —
- (6) Were any formations sealed against pollution?  
yes, no.

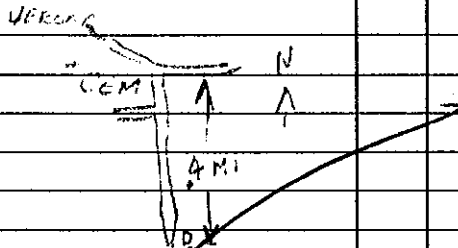

If YES depth of formation: 25'  
Why: surface sand  
Drillers Remarks: [Signature]

224 ELEV 320

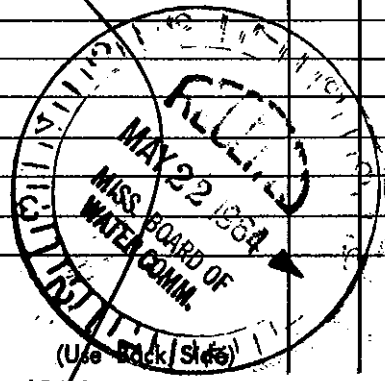

Well No.

Mail this copy to Board of Water Commissioners 429 Miss. St. Jackson, Miss