

LEE

MISSISSIPPI BOARD OF WATER COMMISSIONERS

L 37

5-29-65

WATER WELL DRILLERS LOG

Herndon-Homan Well & Supply, Inc.

Date: May 29, 1965, Driller: P. O. Box 42 SHANNON, MISSISSIPPI 38868 County Lee

(1) Owner of Land:	Description & Color of Materials Sand, Clay, Red Clay, Shell, etc.	Thick- ness Feet	Depth Feet
Clyde Foster (Name) Rt 1, Ponteville, MS (Address)	sand + clay	0 - 20	20 - 200
1/4, 1/4, Sec 14 T 1 R 6 E (distance) (direction) (Nearest Town)	Blue clay	20 - 200	200 - 320
1 miles E of Ponteville (distance) (direction) (Nearest Town)	Sand	200 - 320	Bottom 300
Hilly (Hilly) (Flat) (Level)	second fill on left		
Domestic (Domestic Irrigation Municipal, Industrial, Other)	5th house part check water not full good		


Information upon completion of well:

- (1) Diameter 4 inches.
- (2) Total Depth 320 feet.
- (3) Water Level 95 feet below top of ground.
- (4) Cased to 22' 4", Size 4"
- (5) Screen: Size _____, Length _____
- (6) Were any formations sealed against pollution?
 yes, _____ no.

If YES depth of formation 20'

Why surface + sand

Drillers Remarks:

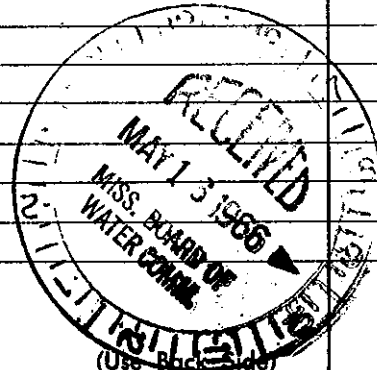

228 KLEU 305

Well No.