

LEE
38
7-19-62

MISSISSIPPI BOARD OF WATER COMMISSIONERS

WATER WELL DRILLERS LOG
MERNDON WELL & SUPPLY CO.

Date: July 18, 1962, Driller: W. LANNON, P. O. BOX 42, WALTON, MISSISSIPPI County Lee


(1) Owner of Land:	Description & Color of Materials	Thick-ness Feet	Depth Feet
<u>Charles Pagen</u> (Name) <u>At Plasterville, Miss</u> (Address)	<u>Surface sand & clay</u>		0
(2) Location: <u>1/4, 1/4, Sec 35 103 T. R. 6E</u> <u>4</u> miles <u>S</u> of <u>Plasterville</u> (distance) (direction) (Nearest Town)	<u>Blue silt</u>		38
(3) Topography: <u>Flat</u> (Hilly) (Flat) (Level)	<u>Sand</u>		160
(4) Purpose of Well: <u>Domestic</u> (Domestic Irrigation Municipal, Industrial, Other)	<u>Bottom</u>		280

Information upon completion of well:

- (1) Diameter 4" inches.
- (2) Total Depth 280 feet.
- (3) Water Level 90 feet below top of ground.
- (4) Cased to 42', Size 4"
- (5) Screen: Size , Length
- (6) Were any formations sealed against pollution?
 yes, no.

Channel exists of HW N of well top

Sec 206

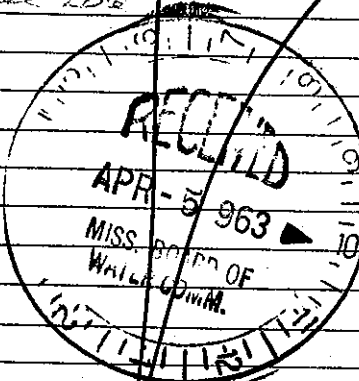

If YES depth of formation 38'
Why Surface & sand
Drillers Remarks: got 1/2 HP

286 ELEV 280

(Use Back Side)

Well No.