

Lee
 L-39
 B-65

MISSISSIPPI BOARD OF WATER COMMISSIONERS

WATER WELL DRILLERS LOG

Date: Aug 13, 1965 (When well drilled) Driller: Herndon-Homan Well & Supply, Inc.
P. O. Box 42 County Lee
SHANNON, MISSISSIPPI 38608 (Where well is located)

(1) Owner of Land: P. P. Davis
 (Name)
At 1 Plantersville, Miss
 (Address)
5 W NE 1/4, Sec. 14 T10 R6 S1E
 (2) Location:
1 miles EAST of Plantersville
 (distance) (direction) (Nearest Town)
 (3) Topography: Hills
 (Hilly) (Flat) (Level)
 (4) Purpose of Well: Domestic
 (Domestic Irrigation) (Municipal, Industrial, Other)

Description & Color of Materials Sand, Clay, Red Clay, Shell, etc.	Thick- ness Feet	Depth Feet
<u>surface sand & clay</u>	<u>20</u>	<u>20</u>
<u>blue clay</u>	<u>140</u>	<u>160</u>
<u>Sand</u>	<u>120</u>	<u>280</u>

Information upon completion of well:

(1) Diameter 4 inches.

(2) Total Depth 280 feet.
9 2:5 2/28/67

(3) Water Level 90 feet below top of ground.

(4) Cased to 23' 6", Size 4"

(5) Screen: Size NONE, Length _____

(6) Were any formations sealed against pollution?
 yes, no.

If YES depth of formation 20'


Why Surface + sand

Drillers Remarks: _____

Yield in gpm: 3

Size pump: 1/4

Type power: Electric

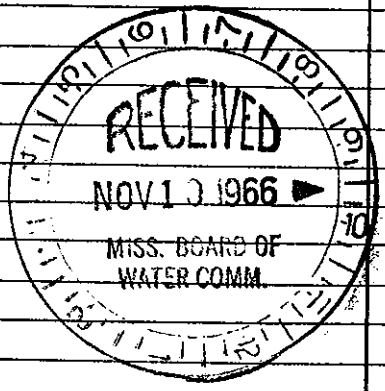

oil this copy to Board of Water Commissioners 429 Miss. St. Jackson, Miss.
 3 8 5 KLEU 305