

Lee  
L40  
3-67

**CODED**

coded

MISSISSIPPI BOARD OF WATER COMMISSIONERS

**WATER WELL DRILLERS LOG**

Herndon-Hoeman Well & Supply, Inc.

Date: 3-11, 1967, Driller: P. O. Box 42 County Lee  
(When well drilled) SHANNON, MISSISSIPPI 38868 (Where well is located)

(1) Owner of Land: CAUL Kelly  
(Name)  
Rt. 2 Tupelo, Miss  
(Address)  
(2) Location: SW 1/4, S1/4, Sec. 2 T10R6E  
2 miles SE of Tupelo  
(distance) (direction) (Nearest Town)  
(3) Topography: Hilly  
(Hilly) (Flat) (Level)  
(4) Purpose of Well: Home  
(Domestic Irrigation  
Municipal, Industrial, Other)


Description & Color of Materials Sand, Clay, Red Clay, Shell, etc.	Thick- ness Feet	Depth Feet
<u>surface sand &amp; clay</u>		<u>0-80</u>
<u>blue clay</u>		<u>80-280</u>
<u>sand</u>		<u>280-400</u>
<u>bottom</u>		<u>400</u>

Information upon completion of well:

(1) Diameter 5 inches.  
(2) Total Depth 400 feet.  
(3) Water Level 165' feet below top of ground.  
(4) Cased to 86' 5", Size 5"  
(5) Screen: Size none, Length \_\_\_\_\_  
(6) Were any formations sealed against pollution?  
✓ yes, \_\_\_\_\_ no.

If YES depth of formation 80'  
Why surface + sand  
Drillers Remarks: \_\_\_\_\_  
Yield in gpm: 5  
Size pump: 1/2 HP Sub.  
Type power: electric

**CODED**

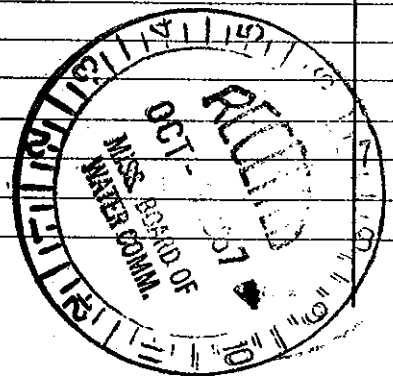

Retain this copy for your office files.