

Lee
~~3-66~~ L41
 3-66

NORTH WELL
 MISSISSIPPI BOARD OF WATER COMMISSIONERS

WATER WELL DRILLERS LOG

Date: 3-28-, 1966, Driller: Layne-Central Co. County Lee
 (Name)

(1) Owner of Land:	Description & Color of Materials Sand, Clay, Red Clay, Shell, etc.	Thick- ness Feet	Depth Feet
Tupelo Industrial Park (Name)	clay	0-12	478'
Tupelo, Mississippi (Address)	soapstone	12-260	
<u>NORTH WELL</u>	soapstone-little		
(2) Location: <u>1/4</u> , <u>1/4</u> , Sec. <u>T</u> <u>R</u> ,	sand st.	260-278	
<u> </u> miles <u> </u> of <u> </u> ,	soapstone	278-296	
(distance) (direction) (Nearest Town)	sandy clay	296-371	
(3) Topography: (Hilly) (Flat) (Level)	sand-draggy st.	371-427	
(4) Purpose of Well: <u>Industrial</u>	sand-shale st.	427-474	
(Domestic Irrigation Municipal, Industrial, Other)	hard shale	474-496	


Information upon completion of well:

- (1) Diameter 12 inches.
- (2) Total Depth 478 feet.
- (3) Water Level 76 feet below top of ground.
- (4) Cased to 387', Size 12"
- (5) Screen: Size 8", Length 80'
- (6) Were any formations sealed against pollution?
 yes, no.

If YES depth of formation 387'

Why required

Drillers Remarks:

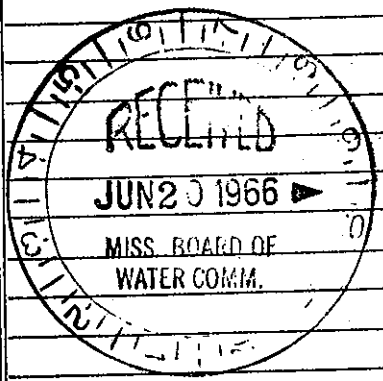

357 ELEV 270

(Use Back Side)

Well No.

Mail this copy to Board of Water Commissioners 429 Miss. St. Jackson, Miss.