

CODED  
CODED

Lee  
L 46  
12-66  
Elec Log

MISSISSIPPI  
BOARD OF WATER COMMISSIONERS  
416 North State Street  
Jackson, Mississippi 39201

WATER WELL DRILLERS LOG

Herndon-Homan Well & Supply, Inc  
P. O. Box 42  
SHANNON, MISSISSIPPI 38868

Dec 10 1966  
date well completed

SHANNON, MISSISSIPPI 38868  
county well located

LANDOWNER: Jamuel Williams  
A.D. Pogue (contractor)  
Nettleton, Miss.  
(mailing address)


description of formations encountered	from	to
<u>upper sand &amp; clay</u>	<u>0</u>	<u>30</u>
<u>blue clay</u>	<u>30</u>	<u>260</u>
<u>sand</u>	<u>260</u>	<u>382</u>
<u>Bottom</u>	<u>382</u>	

WELL LOCATION:  
sec 10 T 10 N R 6 E  
S W  
1 miles NE of Nettleton  
(distance) (direction) (nearest town)

WELL PURPOSE: Home  
(home, irrigation, municipal, industrial)

- WELL COMPLETION DATA:
- (1) diameter (inches) 5"
  - (2) total depth (feet) 380'
  - (3) static water level (feet) 140 below above top of ground.
  - (4) casing Steel 32 1/2"  
(material) (depth)  
(size) If telescope see back.
  - (5) screen None  
(length) (depth to top)  
(size) (material)
  - (6) pump 3/4 6  
(HP) (yield gpm)  
Electric  
(type power)
  - (7) electric log Yes  
(yes or no)  
USGS  
(organization running log)
  - (8) how well bottom plugged open

CODED

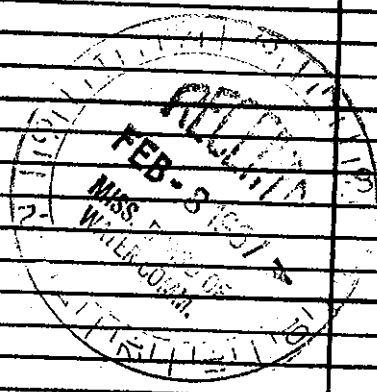

DRILLERS REMARKS:

390