

Lee  
L 48  
7-66

MISSISSIPPI BOARD OF WATER COMMISSIONERS

WATER WELL DRILLERS LOG

Date: 7-28, 1966, Driller: Herndon-Homan Well & Supply, Inc. County: Lee  
(When well drilled) P. O. Box 42 (Where well is located)  
SHANNON, MISSISSIPPI 38868


(1) Owner of Land:	Description & Color of Materials Sand, Clay, Red Clay, Shell, etc.	Thick- ness Feet	Depth Feet
<u>O.B. Towens</u> <small>(Name)</small> <u>Plantersville, Miss.</u> <small>(Address)</small>	<u>surface sand</u>	<u>0-5</u>	
(2) Location: <u>SE 1/4, NW 1/4, Sec 22, T 103, R 6</u> <u>1/2 miles S</u> of <u>Plantersville</u> <small>(distance) (direction) (Nearest Town)</small>	<u>+ clay</u> <u>Blue clay</u> <u>Sand</u> <u>Bottom</u>	<u>5-150</u> <u>180-300</u> <u>300</u>	
(3) Topography: <u>Flat</u> <small>(Hilly) (Flat) (Level)</small>			
(4) Purpose of Well: <u>Domestic</u> <small>(Domestic Irrigation Municipal, Industrial, Other)</small>			

Information upon completion of well:

- (1) Diameter 4 inches.
- (2) Total Depth 300 feet.
- (3) Water Level 80 feet below top of ground.
- (4) Cased to 16' 3", Size 4"
- (5) Screen: Size none, Length \_\_\_\_\_
- (6) Were any formations sealed against pollution?  
 yes,  no.

If YES depth of formation 15'  
 Why surface + sand  
 Drillers Remarks:  
 Yield in gpm: 2 gpm  
 Size pump: 1/2 HP Jet  
 Type power: Electric

CODED

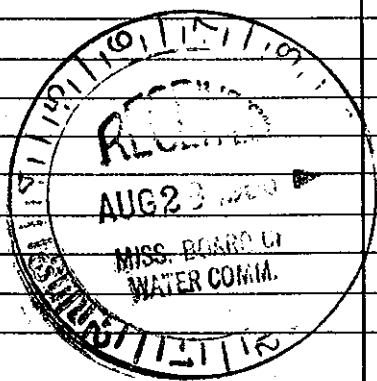

Mail this copy to Board of Water Commissioners 429 Miss. St. Jackson, Miss.