

Lee
L4 CODED

9-67 MISSISSIPPI BOARD OF WATER COMMISSIONERS

WATER WELL DRILLERS LOG

Merndon-Homan Well & Supply, Inc.

Date: 9-4, 1967, Driller: P. O. Box 42 County Lee
(When well drilled) SHANNON, MISSISSIPPI 38868 (Where well is located)

(1) Owner of Land: <u>Willy Walker</u> (Name)	Description & Color of Materials Sand, Clay, Red Clay, Shell, etc.	Thick- ness Feet	Depth Feet
<u>RT 2 SHANNON, Miss</u> (Address)	<u>surface sand</u>	<u>0-33</u>	<u>33</u>
(2) Location: <u>NW 1/4</u> , <u>1/4</u> , Sec. <u>29</u> T <u>10R</u> <u>6E</u> <u>1</u> miles <u>E</u> , of <u>Verona</u> (distance) (direction) (Nearest Town)	<u>+ clay</u>	<u>33</u>	<u>280</u>
(3) Topography: <u>FLAT</u> (Hilly) (Flat) (Level)	<u>Blue clay</u>	<u>280-400</u>	<u>400</u>
(4) Purpose of Well: <u>Home</u> (Domestic Irrigation Municipal, Industrial, Other)	<u>Sand</u>	<u>400</u>	<u>Bottom</u>

Information upon completion of well:

- (1) Diameter 5 inches.
- (2) Total Depth 400 feet.
- (3) Water Level 135 feet below top of ground.
- (4) Cased to 37" 10", Size 5"
- (5) Screen: Size NONE, Length _____
- (6) Were any formations sealed against pollution?
yes, _____ no.

CODED

If YES depth of formation 33'


Why surface + sand

Drillers Remarks: _____

Yield in gpm: 5

Size pump: 1/2 HP sub.

Type power: electric

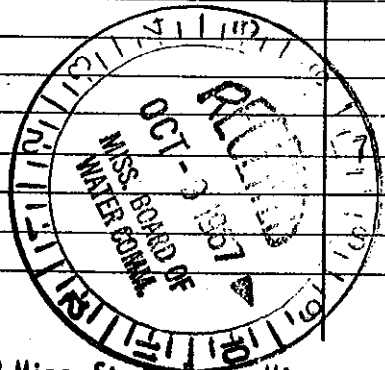

Mail this copy to Board of Water Commissioners 429 Miss. St. Jackson, Miss.