

LEE
L52
2-68

MISSISSIPPI
BOARD OF WATER COMMISSIONERS
416 North State Street
Jackson, Mississippi 39201

WATER WELL DRILLERS LOG
Merndon-Homan Well & Supply, Inc.
P. O. Box 42

2/16 1968
date well completed **JACKSON, MISSISSIPPI 39201** county well located


LANDOWNER:
Jack Fields
Rt 6 Tupelo, Miss.
(mailing address)

description of formations encountered	from	to
super sand clay	0	20
Blue clay	20	300
sand	300	440
Clay	440	

WELL LOCATION:
Sec. 30 T. 10 N. R. 6 E.
S. W.
1/2 miles S of TOLONA
(distance) (direction) (nearest town)

WELL PURPOSE: Home
(home, irrigation, municipal, industrial)

- WELL COMPLETION DATA:**
- diameter (inches) 5 1/4
 - total depth (feet) 440'
 - static water level (feet) 190' below above top of ground
 - casing Steel 23'
(material) (depth)
If telescope see back.
(size)
 - screen none
(length) (depth to top)
(size) (material)
 - pump 1 1/2 HP 10
(HP) (yield gpm)
(type power)
 - electric log no
(yes or no)
(organization running log)
 - how well bottom plugged open

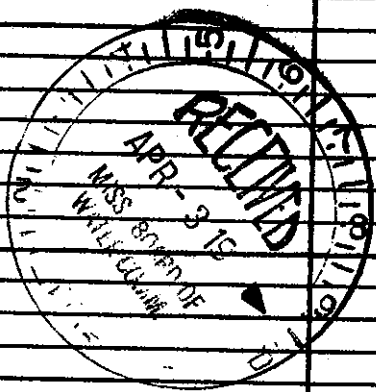

DRILLERS REMARKS: