

EE
L 53 CODED
7-5-60

MISSISSIPPI BOARD OF WATER COMMISSIONERS

WATER WELL DRILLERS LOG

L300

Date: July 5, 1960, Driller: Herndon Well & Supply Co. SHANNON, MISS. County Lee

(Name)

(1) Owner of Land: Wayne Blaylock
(Name)

Rt. 2 Tupelo, Miss.
(Address)

(2) Location: 1/4, 1/4, Sec. 3 T10R6

miles _____ of _____
(distance) (direction) (Nearest Town)

(3) Topography: Hills
(Hilly) (Flat) (Level)

(4) Purpose of Well: Home Use
(Domestic Irrigation
Municipal, Industrial, Other)

Description & Color of Materials
Sand, Clay, Red Clay, Shell, etc.

Thick-
ness
Feet

Depth
Feet

Sand & Clay

120

Blue Bank

120

SAND

240

Bottom

360

Information upon completion of well:

(1) Diameter 4" inches.

(2) Total Depth 360 feet.

(3) Water Level 600 feet below top of ground.

(4) Cased to 120 ft, Size 4"

(5) Screen: Size _____, Length _____


(6) Were any formations sealed against pollution?
X yes, _____ no.

If YES depth of formation 125 ft

Why SURFACE & SAND

Drillers Remarks:

CODED

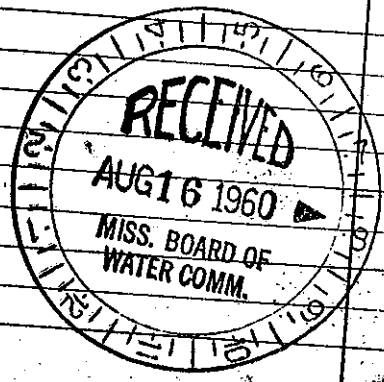

(Use Back Side)

Mail this copy to Board of Water Commissioners 429 Miss. St. Jackson

?
202