

MISSISSIPPI BOARD OF WATER COMMISSIONERS

WATER WELL DRILLERS LOG

L54
9-1-60
CODED

L300


Date: Sept 1, 1960, Driller: O. C. Webb Jr County Lee
(Name)

(1) Owner of Land:	Description & Color of Materials Sand, Clay, Red Clay, Shell, etc.	Thick- ness Feet	Depth Feet
<u>Jem Tedford</u> (Name) <u>Luxelo miss</u> (Address)	<u>Soil to 20ft</u>		
(2) Location: <u>1/4, 1/4, Sec. 11 T10 R5</u> <u>5</u> miles <u>south</u> , of <u>Luxelo</u> (distance) (direction) (Nearest Town)	<u>Blue Rock to</u> <u>150ft sand Rock</u> <u>2 ft sand to 195</u> <u>ft Blue Rock</u> <u>to 380 ft water</u> <u>sand to 530 ft</u>		
(3) Topography: <u>✓</u> (Hilly) (Flat) (Level)			
(4) Purpose of Well: <u>✓</u> (Domestic Irrigation Municipal, Industrial, Other)			

Information upon completion of well:

- (1) Diameter ✓ inches.
- (2) Total Depth 530 feet.
- (3) Water Level 150' feet below top of ground.
- (4) Cased to 199'-7", Size 4"
- (5) Screen: Size 0, Length 0
- (6) Were any formations sealed against pollution?
_____ yes, _____ no.

If YES depth of formation _____
Why _____
Drillers Remarks: not located

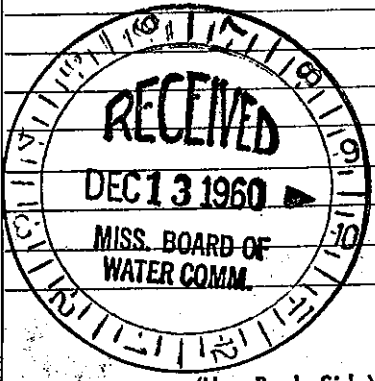

205

Well No.