

LEE MISSISSIPPI BOARD OF WATER COMMISSIONERS
 L56 WATER WELL DRILLERS LOG L305
 4-13-61 CODED

Date: April 13 19 61, Driller: HERNDON WELL & SUPPLY CO.
 P.O. BOX 42 County Lee
 SHANNON, MISSISSIPPI


	Description & Color of Materials Sand, Clay, Red Clay, Shell, etc.	Thick- ness Feet	Depth Feet
(1) Owner of Land: <u>Ray Patrice</u> (Name) <u>Plantersville, Miss.</u> (Address)	<u>Surface Sand</u>		<u>0</u>
(2) Location: <u>1/4, 1/4, Sec. 15 T 105 R 6 E</u> <u>1</u> miles <u>North E.</u> of <u>Plantersville</u> (distance) (direction) (Nearest Town)	<u>clay</u> <u>Blue rock</u> <u>Sand</u>		<u>35</u> <u>240</u>
(3) Topography: <u>Hilly</u> (Hilly) (Flat) (Level)	<u>Bottom</u>		<u>360</u>
(4) Purpose of Well: <u>Home use</u> (Domestic Irrigation Municipal, Industrial, Other)			

Information upon completion of well:

- (1) Diameter 4 inches.
- (2) Total Depth 360 feet.
- (3) Water Level 130 feet below top of ground.
- (4) Cased to 39' 3", Size 4
- (5) Screen: Size , Length
- (6) Were any formations sealed against pollution?
 yes, no.

If YES depth of formation 35'
 Why Surface sand
 Drillers Remarks:

208

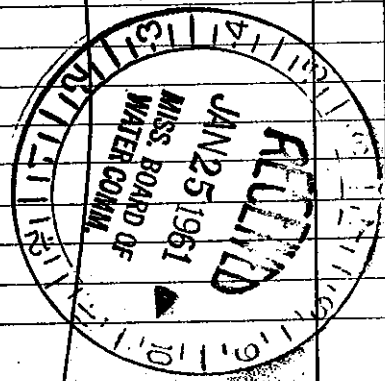

(Use Back Side)

Well No.